IREDELL COUNTY HEALTH DEPARTMENT

STATESVILLE 704-878-5305 MOORESVILLE 704-664-5281

IMPROVEMENT PERMIT / CERTIFICATE OF COMPLETION / OPERATION PERMIT / EXISTING SYSTEM INSPECTION

PROPERTY DESCRIPTION NO. 17543 DATE 12/9/93 TAX MAP NO. 1E-4-A-57 Watershed: ☑ Yes ☐ No

OWNER OR CONTRACTOR Linn Shank PHONE: Business _____ Home 537-1201

ADDRESS 6401 Randy Dr. Charlotte, NC. 28215

LOCATION Timberview - Sherrill TL on Rightturn TL on Millpond Rd. to end of road (R) half of culdesac

SUBDIVISION Timberview BLOCK / SECTION 3 LOT 57 LOT AREA ~1.48 SITE CLASS. UP DESIGN FLOW 240 L.T.A.R. .3

Septic Tank: 1000 Gallons; STB 782 Date 11/15/93

Pump Tank: _____ Gallons; PT _____ Date _____

Pump Make: _____ Model _____ Serial No. _____

Nitrification Field: No Fields 1 Square Feet 800 Linear Feet 266

No Lines 4 Trench Width 3' Max Trench Bottom Depth 36" Gravel Depth _____

☑ New System ☐ Repair System Type: I (II) III, IV, V, VI

System Description: CONV - DROP BOX

Repair System Description: _____

Maintenance Agreement Required: ☐ Yes ☑ No

☐ House/Mod. Home No. Bedrooms 2

☑ Mobile Home No. Bathrooms 2

☐ Business No. Employees _____

☐ Other _____


☐ Slab ☐ Crawl Space ☐ Basement w/plumbing ☐ Basement wo/plumbing

Water Supply: ☑ Individual ☐ Community ☐ Public

Comments: Lines on slope contour in direction shown - Keep driveway off the drainfield

Comments:

INITIAL SITE SKETCH

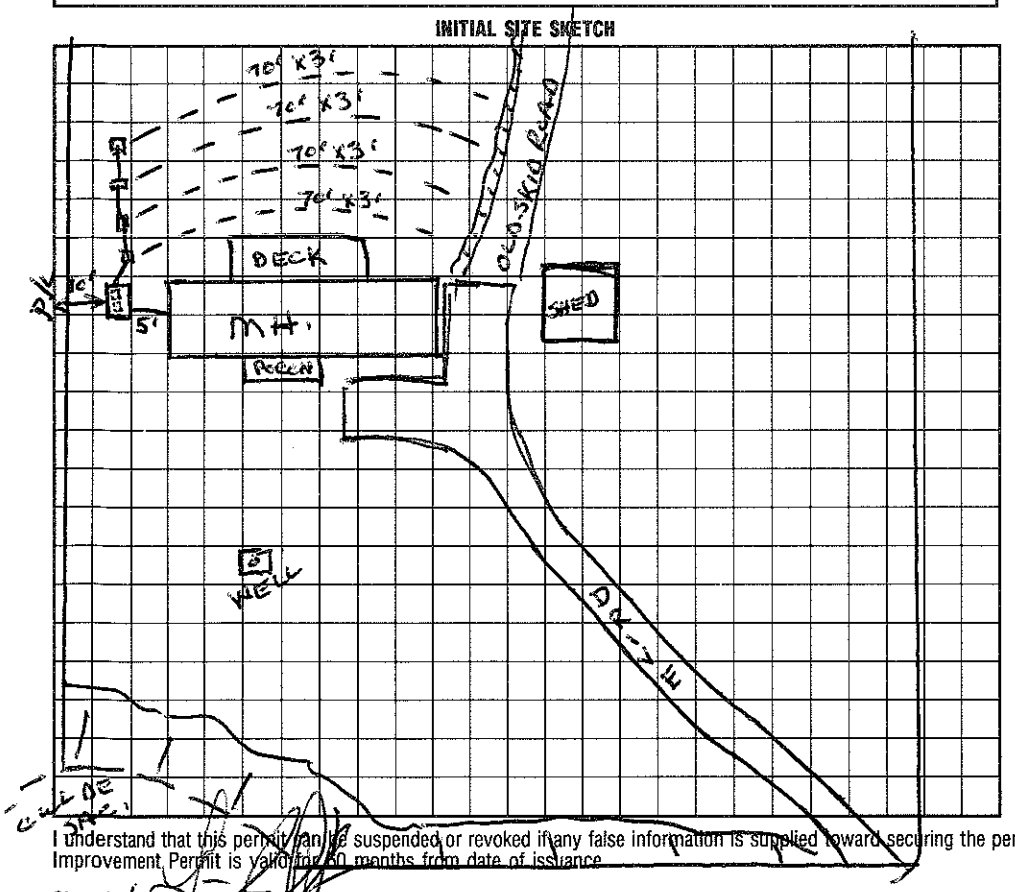

AS BUILT SKETCH

I understand that this permit can be suspended or revoked if any false information is supplied toward securing the permit/any unauthorized changes are made to the site/any unauthorized changes are made in the installation of the system. Improvement Permit is valid for 60 months from date of issuance

Signed: _____

Improvement Permit by: Wesley Sparks R.S. date 12/9/93

Existing System Inspection by: _____ date _____

Installed by: F-J Ervin

Certificate of Completion by: Wesley Sparks R.S. date 12/22/93

Operation Permit by: _____ date _____

HEALTH DEPT. COPY: WHITE INSPECTION COPY (FINAL): GREEN OWNER COPY (FINAL): YELLOW INSPECTION COPY (INITIAL): PINK OWNER COPY (INITIAL): GOLD