IREDELL COUNTY HEALTH DEPARTMENT

Statesville Office (704) 878-5305 Mooresville Office (704) 660-3625 PERMIT # 208230

IMPROVEMENT PERMIT / AUTHORIZATION TO CONSTRUCT / OPERATION PERMIT / EXISTING SYSTEM

PIN # 4665-71-0008.000

APPLICANT: Kenneth S. Young APPLICANT ADDRESS: 192 Johnson Dairy Rd. Mooresville NC 28115

SITE ADDRESS: 192 Johnson Dairy Rd. Mooresville NC PHONE: 704-664-1103 ALT. PHONE: 704-502-0327

SITE DIRECTIONS: Shearers Rd. to Johnson Dairy. Site on L

SUBDIVISION: — SECTION: — LOT # — LOT AREA: 2 ACRE DESIGN FLOW: 360 GPD L.T.A.R.: .3 EXISTING

Septic Tank 1000 EXISTING (gal) STB Date

Pump Tank (gal) PT Date

Pump Make Model Serial #

Nitrification Fields 1 # Lines 4@100 EXISTING Linear Ft: 400 EX.

Trench Width 30" EX. Max. Trench Bottom Depth EX. Gravel Depth 12" EX.

☐ New System ☐ Repair ☐ Expansion System Type: I II III IV V VI

System Description: EXISTING CONVENTIONAL GRAV.

Repair System Description: SAME

Maintenance Agreement Required: ☐ YES ☒ NO

☒ GRAVITY ☐ PRESSURE

☒ Residence No. Bedrooms 3

☐ Business No. Persons 6

☐ Other No. Employees


☐ Slab ☒ Crawl Space

☐ Basement w/plumbing ☐ Basement w/o plumbing


Water Supply: ☒ Private ☐ Public ☐ Community

Comments / Conditions: THIS PERMIT IS FOR THE ADDITION TO EXISTING HOUSE WITH AN ARTIFACT ROOM AND GENERAL LIVING SPACE. SYSTEM APPEARED TO BE FUNCTIONING PROPERLY AT TIME OF INSPECTION.

INITIAL SITE SKETCH

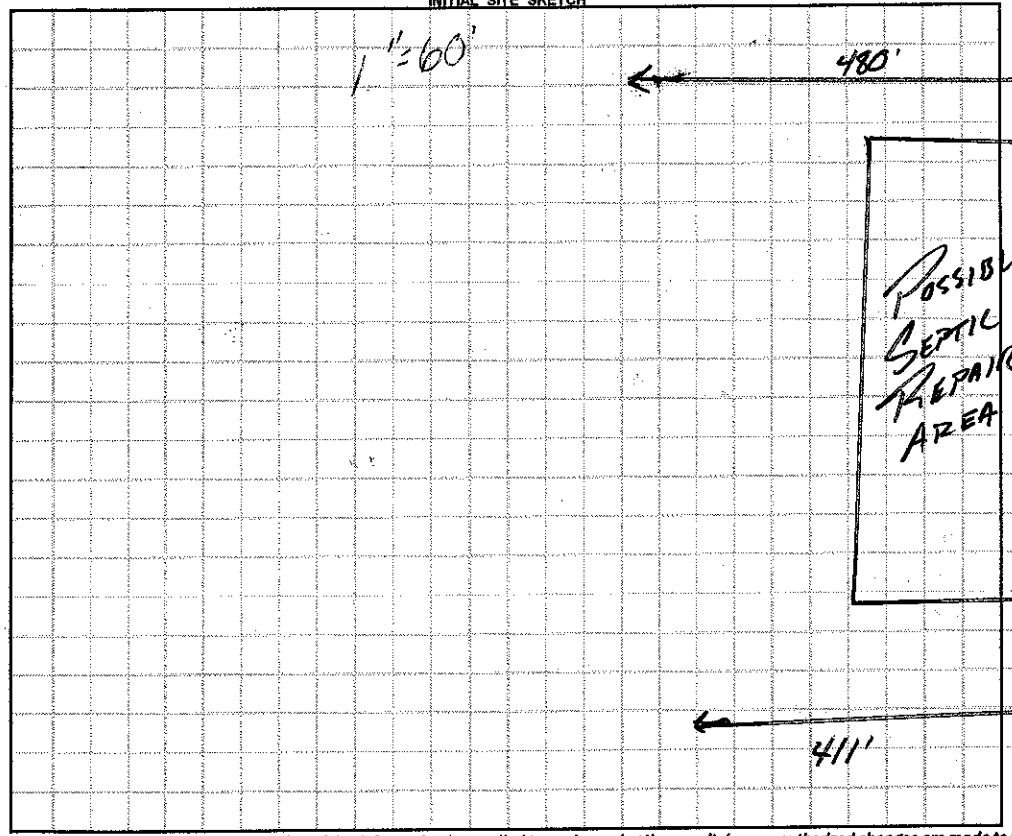

AS BUILT SKETCH

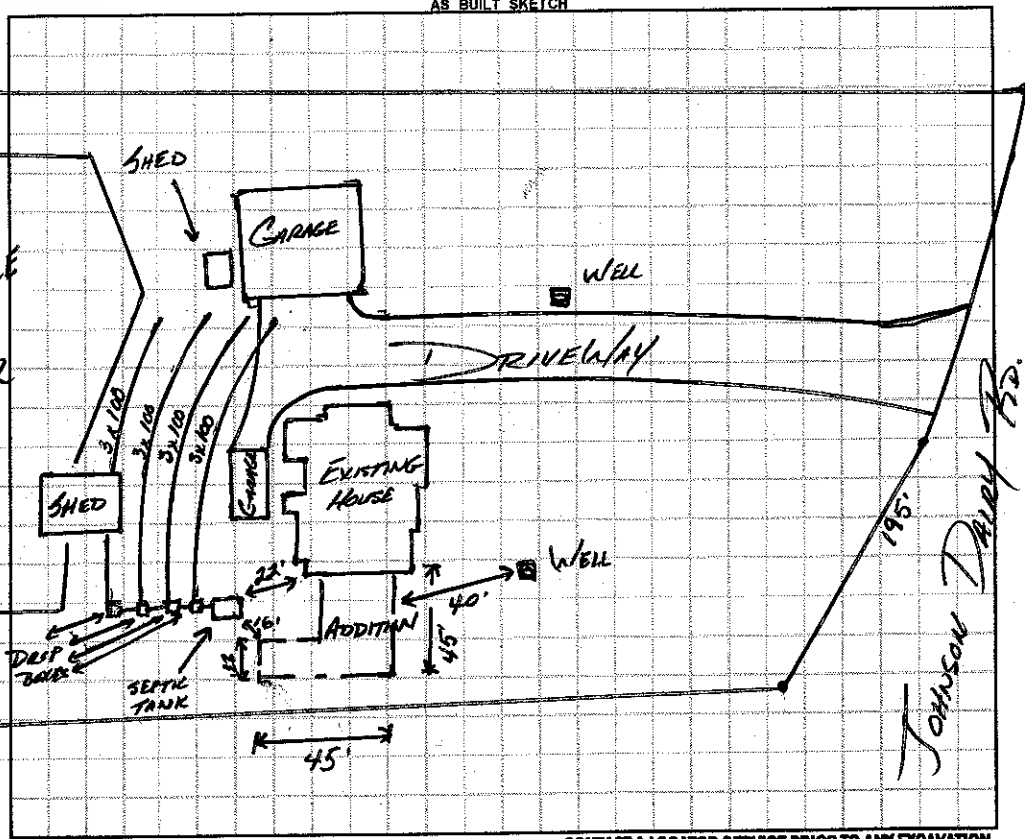

Permit can be suspended or revoked if any false information is supplied toward securing the permit / any unauthorized changes are made to the site / any unauthorized changes are made in the installation of the system. **CONTACT A LOCATOR SERVICE PRIOR TO ANY EXCAVATION**

☐ **IMPROVEMENT PERMIT** *with plat, valid without expiration.* ☐ **IMPROVEMENT PERMIT** *with site plan valid for 60 mos.* ☐ **AUTHORIZATION TO CONSTRUCT** *valid for period equal to IMPROVEMENT PERMIT--not to exceed 60 mo.*

Owner / Applicant Signature: Kenneth S. Young Date: 3-12-2015 Installed by:

IMPROVEMENT PERMIT by: Date: OPERATION PERMIT by: Date:

AUTHORIZATION TO CONSTRUCT by: Date: Existing System Inspected by: APPROVED MAR 11 2015

Health Dept. Copy - WHITE Applicant (Final Approval) - YELLOW Applicant (Conditional Approval) - PINK