IREDELL COUNTY HEALTH DEPARTMENT

STATESVILLE 704-878-5305 50.00 Paid MOORESVILLE 704-664-5281

IMPROVEMENT PERMIT / AUTHORIZATION TO CONSTRUCT / OPERATION PERMIT / EXISTING SYSTEM INSPECTION

PERMIT# 104369 PIN# ~~4665-71-0870~~ 4665721121 DATE 5/20/02

OWNER OR CONTRACTOR Edward Douthit PHONE: Business 704-663-4126 Home

ADDRESS 189 Johnson Dairy Rd. Mooresville, NC 28115

LOCATION Shoams Rd. TL Johnson Dairy Rd. TL # 189 on (L) take new drive on (L) to rear of property

SUBDIVISION No BLOCK / SECTION LOT LOT AREA 2.364C SITE CLASS. PS DESIGN FLOW 360 L.T.A.R. .3

Septic Tank: 1000 Gallons; STB 1012 Date 3/25/02

Pump Tank: Gallons; PT Date

Pump Make: Model Serial No.

Nitrification Field: No Fields 1 Square Feet 900 Linear Feet 300

No Lines 3@100' Trench Width 3' Max Trench Bottom Depth 3' Gravel Depth 12"

☒ New System ☐ Repair System Type: I, II, (III) IV, V, VI

System Description: EZLAY on CH. PLASTIC

Repair System Description: SAME

Maintenance Agreement Required: ☐ Yes ☒ No

☐ House/Mod. Home ☒ Mobile Home ☐ Business ☐ Other

No. Bedrooms 3 No. Bathrooms 2 No. Employees

☐ Slab ☒ Crawl Space ☐ Basement w/plumbing ☐ Basement wo/plumbing


Water Supply: ☒ Individual ☐ Public ☐ Community

Comments:/Conditions: Changed to 300' Type 3 trenfield gravity distributed - AWS.

INITIAL SITE SKETCH

Comments:/Conditions:

AS BUILT SKETCH

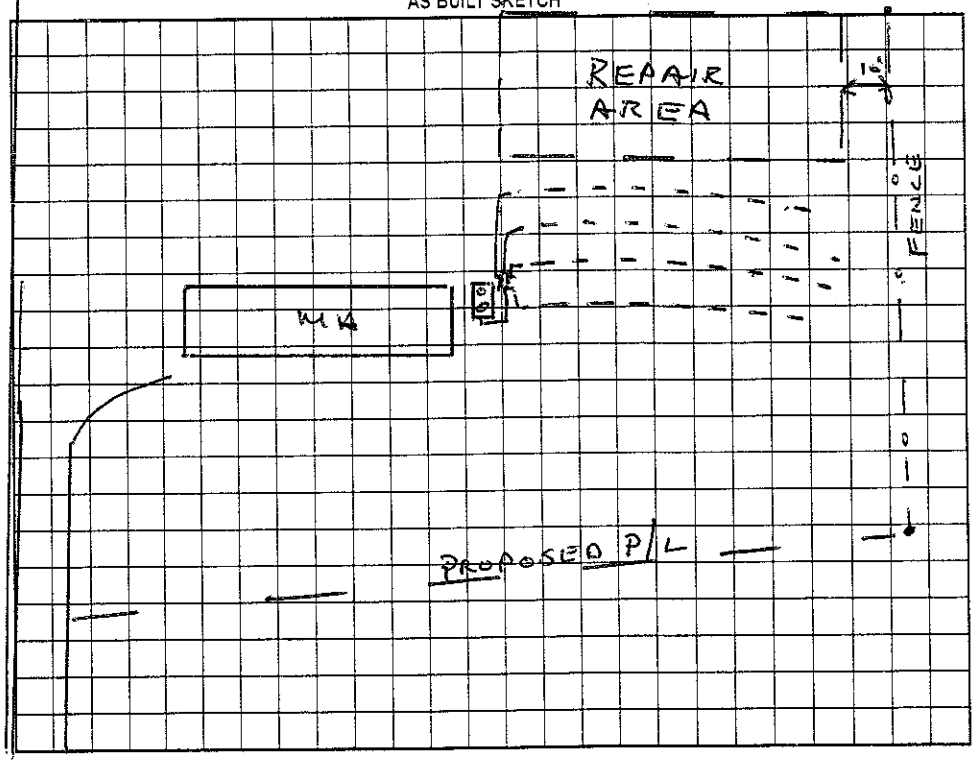

Permit can be suspended or revoked if any false information is supplied toward securing the permit/any unauthorized changes are made to the site/any unauthorized changes are made in the installation of the system. Improvement Permit with plat valid without expiration. Improvement Permit with site plan valid for sixty months. Authorization to Construct is valid for a period equal to that of Improvement Permit – not to exceed sixty months.

Signed: Edward Douthit date 5-21-02

Improvement Permit by: AWS date

Authorization to Construct by: AWS. date

Installed by: Richard Abernathy

Operation Permit by: Wesley Parker RS. date 5/20/02

Existing System Inspection by: date

HEALTH DEPT. COPY: WHITE OWNER COPY (FINAL): YELLOW OWNER COPY (INITIAL): PINK