IREDELL COUNTY HEALTH DEPARTMENT

STATESVILLE 704-878-5305 175.00 Paid MOORESVILLE 704-664-5281

IMPROVEMENT PERMIT / AUTHORIZATION TO CONSTRUCT / OPERATION PERMIT / EXISTING SYSTEM INSPECTION

PERMIT# 104369 PIN# 4665-71-0840 DATE 1/28/02

OWNER OR CONTRACTOR Edward Dauthit PHONE: Business 704-663-4126 Home

ADDRESS 189 Johnson Dairy Rd. Mooresville, NC 28115

LOCATION Shearins Rd. TL Johnson Dairy Rd. TL # 189 on (L) take new drive on (L) to rear of property

SUBDIVISION No BLOCK / SECTION LOT LOT AREA 2.36AC SITE CLASS PS DESIGN FLOW 360 L.T.A.R. .3

Septic Tank: 1000 Gallons; STB 1012 Date 3/25/02

Pump Tank: 1000 Gallons; PT Date

Pump Make: Model Serial No.

Nitrification Field: No Fields 1 Square Feet 1200 Linear Feet 400 300

No Lines 4@100' Trench Width 3' Max Trench Bottom Depth 3' Gravel Depth 12"

☒ New System ☐ Repair System Type: I. II. III. IV. V. VI

System Description: PressMan → Conventional

Repair System Description: Same

Maintenance Agreement Required: ☐ Yes ☒ No

☒ House/Mod. Home ☐ Mobile Home ☐ Business ☐ Other

No. Bedrooms 3 No. Bathrooms 2 No. Employees


☐ Slab ☒ Crawl Space ☐ Basement w/plumbing ☐ Basement wo/plumbing

Water Supply: ☒ Individual ☐ Public ☐ Community AT HOUSE


Comments/Conditions: P/L's (1"=50')

Comments/Conditions: EZ Lay chamber Method.

INITIAL SITE SKETCH

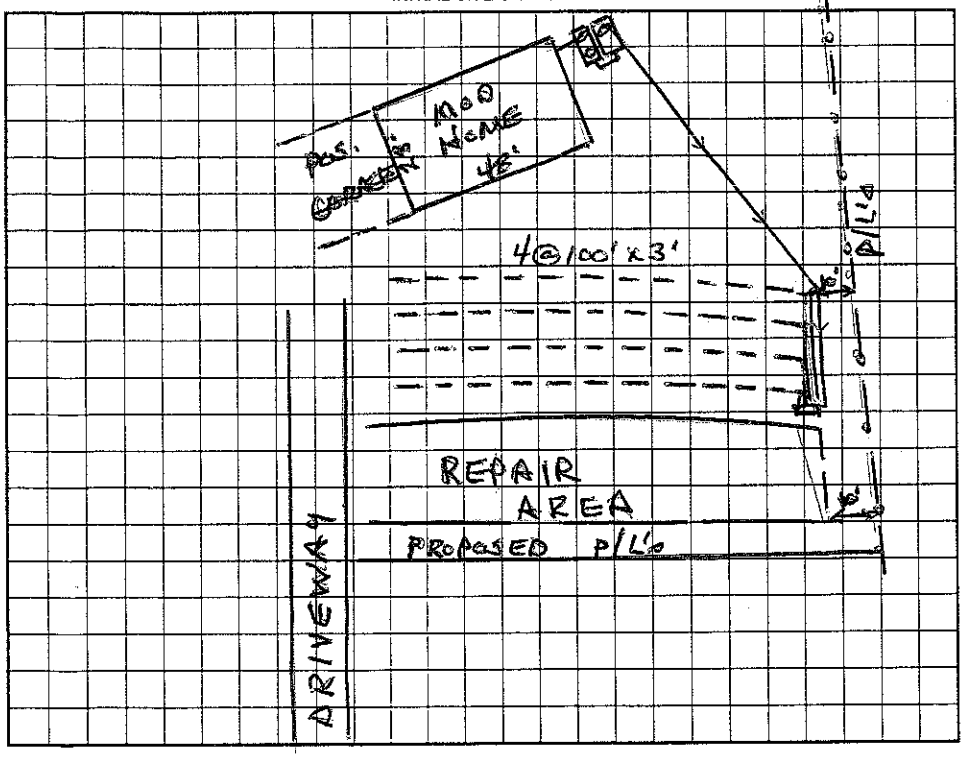

AS BUILT SKETCH

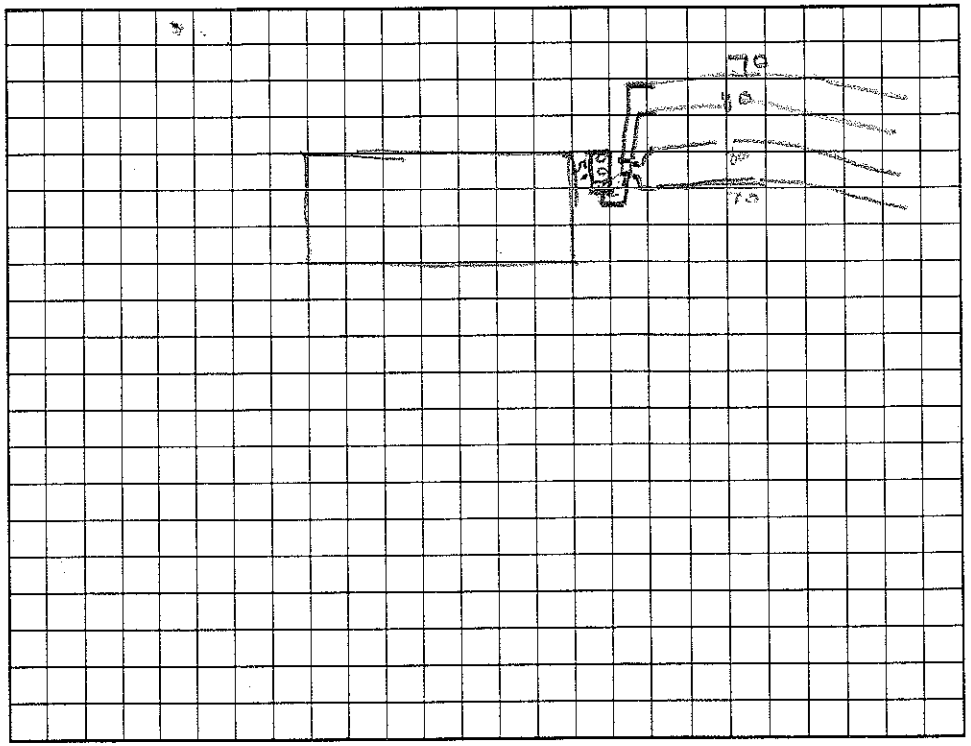

Permit can be suspended or revoked if any false information is supplied toward securing the permit/any unauthorized changes are made to the site/any unauthorized changes are made in the installation of the system. Improvement Permit with plat valid without expiration. Improvement Permit with site plan valid for sixty months. Authorization to Construct is valid for a period equal to that of Improvement Permit – not to exceed sixty months.

Signed: Edward Dauthit date 1-31-02 Installed by: Richard Abernathy

Improvement Permit by: Wesley Sparks R.S. date 1/29/02 Operation Permit by: date

Authorization to Construct by: Wesley Sparks R.S. date 1/28/02 Existing System Inspection by: date

HEALTH DEPT. COPY: WHITE OWNER COPY (FINAL): YELLOW OWNER COPY (INITIAL): PINK