IREDELL COUNTY HEALTH DEPARTMENT

Authorization to Construct 4665765147

STATESVILLE 704-878-5305 MOORESVILLE 704-664-5281

IMPROVEMENT PERMIT / ~~CERTIFICATE OF COMPLETION~~ / OPERATION PERMIT / EXISTING SYSTEM INSPECTION

PROPERTY DESCRIPTION NO. 23323 DATE 5/15/96 TAX MAP NO. 1E-1-B-5 pt of Watershed: ☐ Yes ☑ No

OWNER OR CONTRACTOR George Curtis PHONE: Business _____ Home 857-3555

ADDRESS 120 Dogwood estates China Grove NC 28023 Before

LOCATION Shepherds Rd. S. TL Rocky River Rd, on Rt ~~left~~ Kistler Rd

SUBDIVISION N/A BLOCK / SECTION _____ LOT N/A LOT AREA ± 1 ac SITE CLASS. PS DESIGN FLOW 360 gpd L.T.A.R. .3 gpd/ft²

Septic Tank: 1000 Gallons; STB 724 Date 7/16/96

Pump Tank: _____ Gallons; PT _____ Date _____

Pump Make: _____ Model _____ Serial No. _____

Nitrification Field: No Fields 1 Square Feet 1200 Linear Feet 400

No Lines 4 Trench Width 36" Max Trench Bottom Depth 36" Gravel Depth 12"

☑ New System ☐ Repair System Type: I, II, III, IV, V, VI

System Description: Gravity Conventional Same

Repair System Description: _____

Maintenance Agreement Required: ☐ Yes ☑ No

☑ House/Mod. Home No. Bedrooms 3

☐ Mobile Home No. Bathrooms 2

☐ Business No. Employees _____

☐ Other _____


☐ Slab ☑ Crawl Space ☐ Basement w/plumbing ☐ Basement wo/plumbing

Water Supply: ☑ Individual ☐ Community ☐ Public

Comments:

Comments:

INITIAL SITE SKETCH

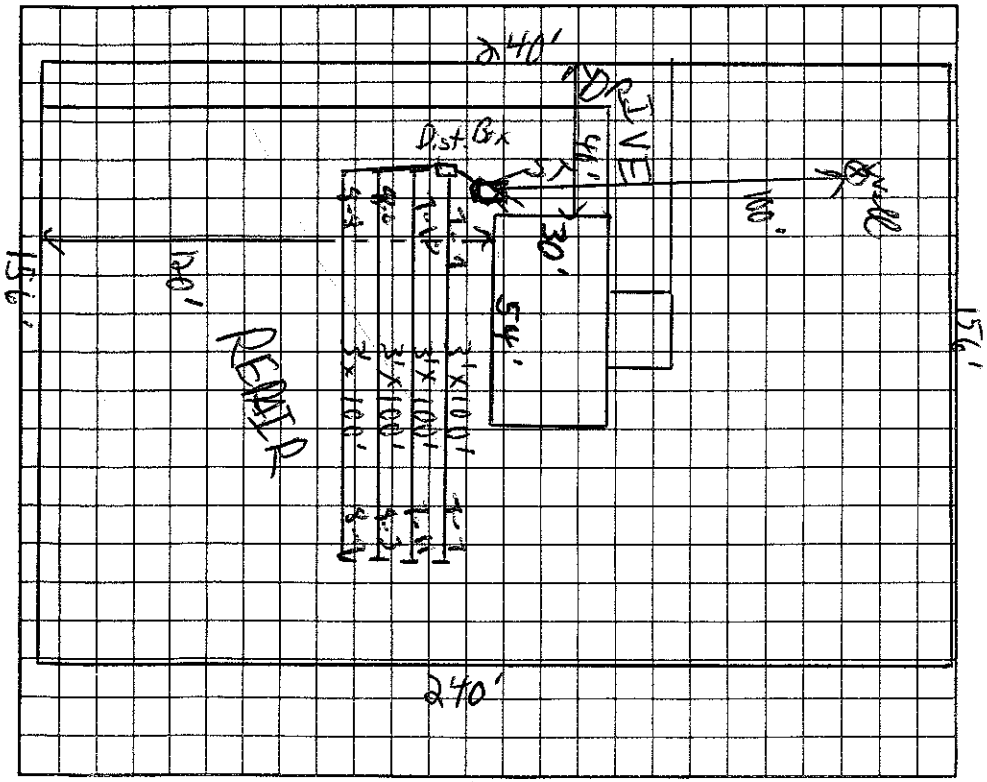

AS BUILT SKETCH

I understand that this permit can be suspended or revoked if any false information is supplied toward securing the permit/any unauthorized changes are made to the site/any unauthorized changes are made in the installation of the system.

Signed: George Curtis

Installed by: F J Ervin

Improvement Permit by: C. Rudy Freeman EHST date 5/15/96

Authorization to Construct

~~Existing System Inspection by:~~ _____ date _____

Certificate of Completion by: _____ date _____

Operation Permit by: Wesley Sparkes date 10/3/96

HEALTH DEPT. COPY: WHITE INSPECTION COPY (FINAL): GREEN OWNER COPY (FINAL): YELLOW INSPECTION COPY (INITIAL): PINK OWNER COPY (INITIAL): GOLD

Authorization to Construct