IREDELL COUNTY HEALTH DEPARTMENT

STATESVILLE 704-878-5305 MOORESVILLE 704-664-5281

IMPROVEMENT PERMIT / CERTIFICATE OF COMPLETION / OPERATION PERMIT / EXISTING SYSTEM INSPECTION

PROPERTY DESCRIPTION NO. 3092 DATE 2/10/95 TAX MAP NO. 1E 2A 1 4665 793670 Watershed: ☐ Yes ☑ No

OWNER OR CONTRACTOR GOFORTH CONST. CO PHONE: Business 664-3825 Home

ADDRESS 188 QUEENS COVE RD. M'VILLE

LOCATION KISTLER RD, ON (R) PAST MEADOWBROOK ENTRANCE

SUBDIVISION MEADOWBROOK BLOCK / SECTION A LOT 1 LOT AREA 15246 FT² SITE CLASS. 4 DESIGN FLOW 360 L.T.A.R. -0-

Septic Tank: 1000 Gallons; STB 825 Date 3/20/95

Pump Tank: 1000 Gallons; PT 47 Date 3/20/95

Pump Make: ; Model Serial No.

Nitrification Field: No Fields N/A Square Feet Linear Feet

No Lines Trench Width Max Trench Bottom Depth Gravel Depth

☑ New System ☐ Repair System Type: I, II, (III) IV, V, VI

System Description: PRESSURE TO SEWER

Repair System Description:

Maintenance Agreement Required: ☐ Yes ☐ No

☑ House/Mod. Home No. Bedrooms 3

☐ Mobile Home No. Bathrooms 2

☐ Business No. Employees

☐ Other


☐ Slab ☑ Crawl Space ☐ Basement w/plumbing ☐ Basement wo/plumbing

Water Supply:
☑ Individual
☑ Community
☐ Public


Comments: < 20,000 FT² - 4 SOIL CONDITIONS
ALARM MOUNTED IN HOUSE - WITH FLOATS
AS NORMALLY REQUIRED

Comments:

INITIAL SITE SKETCH

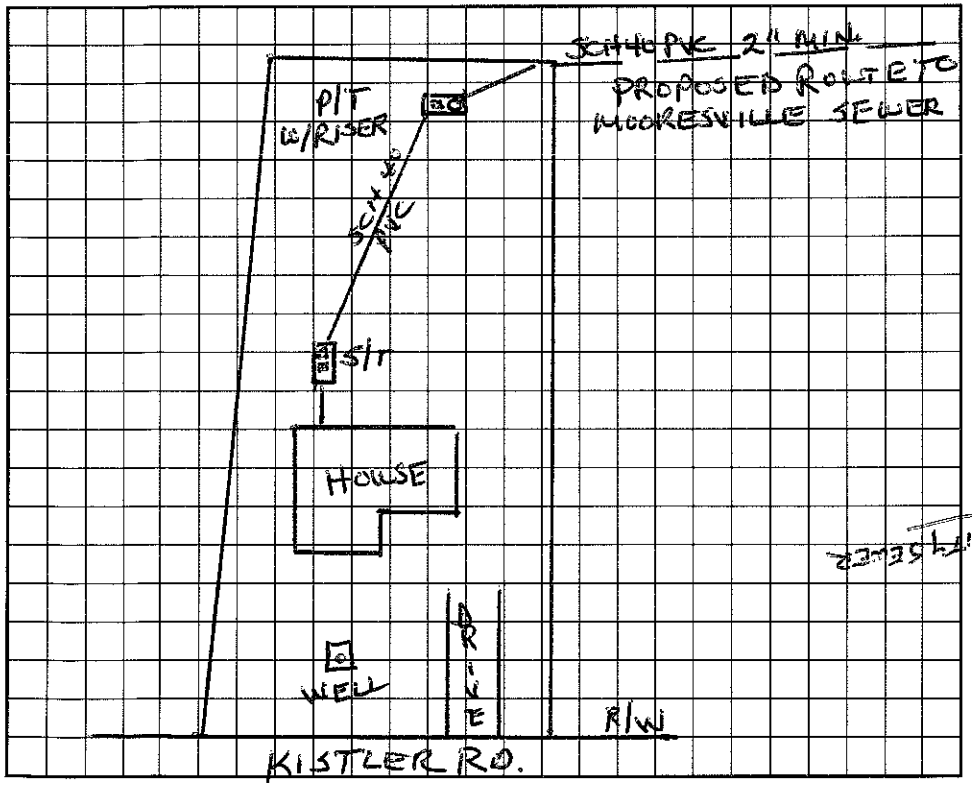

AS BUILT SKETCH

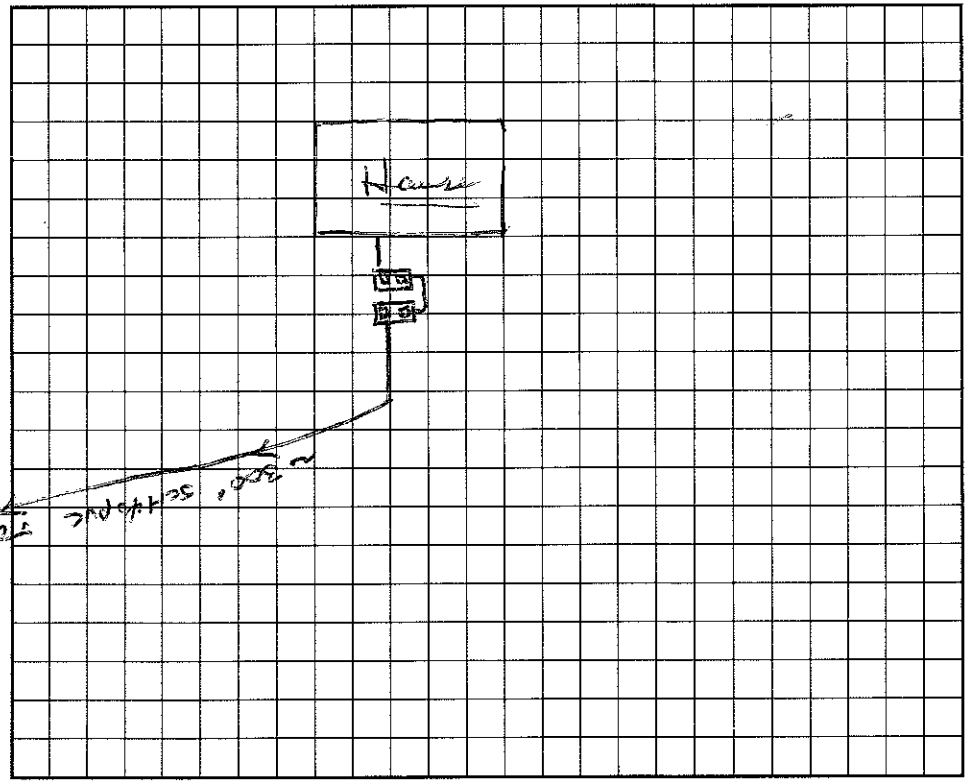

I understand that this permit can be suspended or revoked if any false information is supplied toward securing the permit/any unauthorized changes are made to the site/any unauthorized changes are made in the installation of the system. Improvement Permit is valid for 60 months from date of issuance.

Signed:

Improvement Permit by: Wesley Sparks. date 2/10/95

Existing System Inspection by: date

Installed by: Tim Commons

Certificate of Completion by: Wesley Sparks. date 5/11/95

Operation Permit by: date

HEALTH DEPT. COPY: WHITE INSPECTION COPY (FINAL): GREEN OWNER COPY (FINAL): YELLOW INSPECTION COPY (INITIAL): PINK OWNER COPY (INITIAL): GOLD