IREDELL COUNTY HEALTH DEPARTMENT

STATESVILLE 704-878-5305 — MOORESVILLE 704-664-5281

IMPROVEMENT PERMIT / AUTHORIZATION TO CONSTRUCT / OPERATION PERMIT / EXISTING SYSTEM INSPECTION

PERMIT# 105031 PIN# 4665 81 0799 DATE 3/18/02

OWNER OR CONTRACTOR Peter Demao PHONE: Business 704-896-0208 Home

ADDRESS 21400 Rosslar Ct. Cornelius, NC. 28031

LOCATION 1365 S TR Johnson Dairy Rd. TR. Willow Ridge Farm on (R) before barns

SUBDIVISION Willow Ridge Farm BLOCK / SECTION LOT LOT AREA ~24.35 SITE CLASS: PS DESIGN FLOW 360 L.T.A.R. .3

Septic Tank: 1000 Gallons; STB 143605 Date Plastic
Pump Tank: Gallons; PT Date
Pump Make: Model Serial No.
Nitrification Field: No Fields 1 Square Feet 900 ✱ Linear Feet 300 ✱
No Lines 5@ 60' Trench Width 3' Max Trench Bottom Depth 30" Gravel Depth No

X New System ☐ Repair System Type: I, II, (III), IV, V, VI
System Description: GRAV - E2 FLOW - CH PLASTIC
Repair System Description: SAME
Maintenance Agreement Required: ☐ Yes ☐ No

X House/Mod. Home No. Bedrooms 3
☐ Mobile Home No. Bathrooms 1
☐ Business No. Employees
☐ Other
☐ Slab X Crawl Space ☐ Basement w/plumbing ☐ Basement wo/plumbing


Water Supply: X Individual ☐ Public ☐ Community

Comments:/Conditions:

Comments:/Conditions:

1" = 50'

INITIAL SITE SKETCH

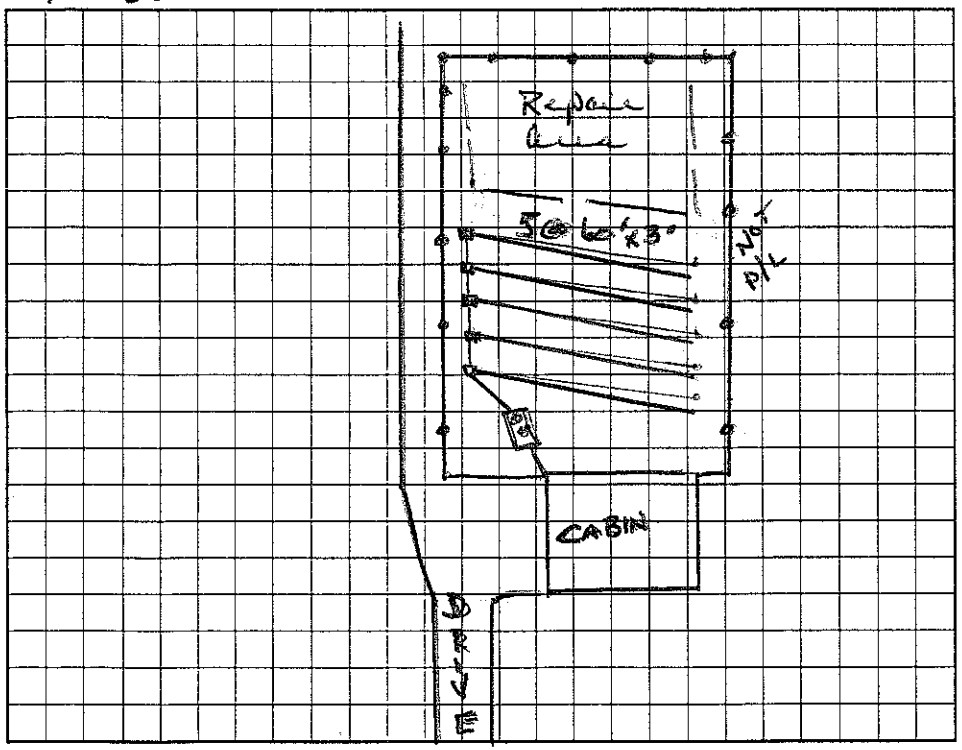

AS BUILT SKETCH

Permit can be suspended or revoked if any false information is supplied toward securing the permit/any unauthorized changes are made to the site/any unauthorized changes are made in the installation of the system. Improvement Permit with plat valid without expiration. Improvement Permit with site plan valid for sixty months. Authorization to Construct is valid for a period equal to that of Improvement Permit – not to exceed sixty months.

Signed: ✱ Peter DeMao date 3/21/02

Improvement Permit by: Wesley Sparks RS. date 3/18/02

Authorization to Construct by: Wesley Sparks RS date 3/18/02

Installed by: Barry Seamon

Operation Permit by: [signature] RS date 4/19/02

Existing System Inspection by: date

HEALTH DEPT. COPY: WHITE OWNER COPY (FINAL): YELLOW OWNER COPY (INITIAL): PINK