IREDELL COUNTY HEALTH DEPARTMENT

STATESVILLE 704-878-5305 MOORESVILLE 704-664-5281

IMPROVEMENT PERMIT / AUTHORIZATION TO CONSTRUCT / OPERATION PERMIT / EXISTING SYSTEM INSPECTION

PERMIT# 132837 PIN# ~~4675-02-5464~~ 4606903445 DATE 3/2/06

OWNER OR CONTRACTOR Donald + Judith Morrison PHONE: Business _____ Home _____

ADDRESS 327 Johnson Dairy Ln Mooresville NC 28115

LOCATION HWY 3, TR Johnson Dairy on Rt past Rocky River # 317

SUBDIVISION _____ BLOCK / SECTION _____ LOT _____ LOT AREA ≈ 30,000 ft² SITE CLASS. PS DESIGN FLOW 360 L.T.A.R. 0.2

Septic Tank: 1000 Gallons; STB 794 Date 11/29/05
Pump Tank: _____ Gallons; PT _____ Date _____
Pump Make: _____ Model _____ Serial No. _____
Nitrification Field: No Fields 1 Square Feet 1350 Linear Feet 450
No Lines 5@90' Trench Width 36" Max Trench Bottom Depth ~~36~~ 24" Gravel Depth —

☒ New System ☐ Repair System Type: I, (II), III, IV, V, VI
System Description: Gravity 25% Reduct.
Repair System Description: LP Panel Block
Maintenance Agreement Required: ☐ Yes ☒ No


☒ House/Mod. Home No. Bedrooms 3
☐ Mobile Home No. Bathrooms ____
☐ Business No. Employees ____
☐ Other _____
☐ Slab ☒ Crawl Space ☐ Basement w/plumbing ☐ Basement wo/plumbing

Water Supply: ☒ Individual ☐ Public ☐ Community


Comments:/Conditions:

Comments:/Conditions:

INITIAL SITE SKETCH

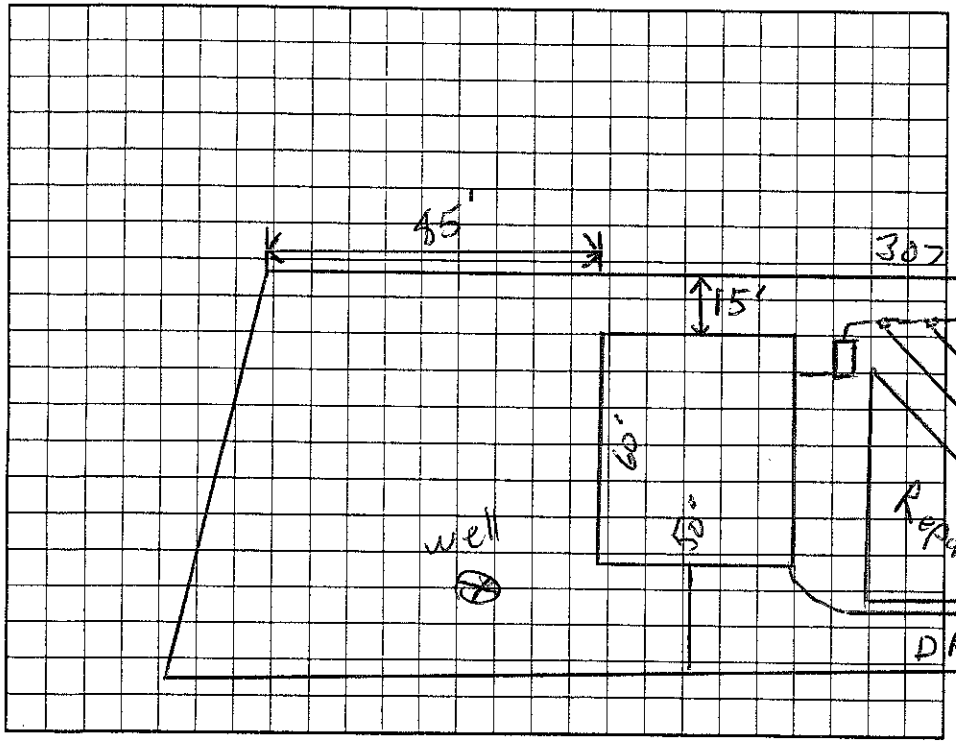

AS BUILT SKETCH

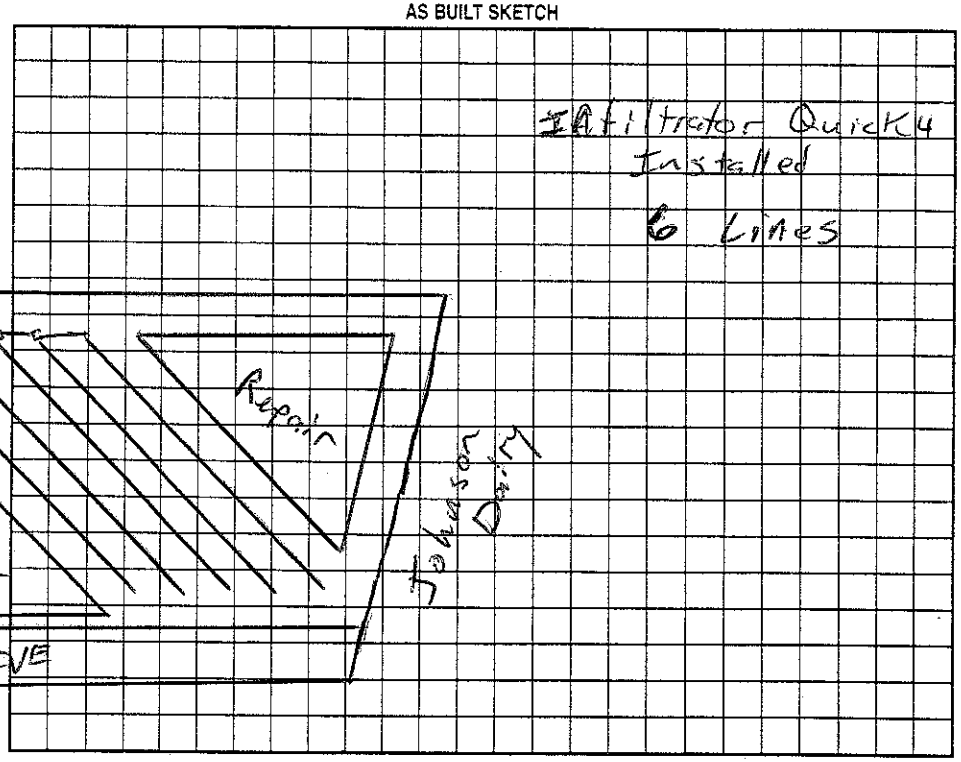

Permit can be suspended or revoked if any false information is supplied toward securing the permit/any unauthorized changes are made to the site/any unauthorized changes are made in the installation of the system. Improvement Permit with plat valid without expiration. Improvement Permit with site plan valid for sixty months. Authorization to Construct is valid for a period equal to that of Improvement Permit – not to exceed sixty months.

Signed: Donald C. Morrison date 3/3/06 Installed by: CD Roseman

Improvement Permit by: _____ RS date 3/2/06 Operation Permit by: _____ RS date 9/29/06

Authorization to Construct by: _____ RS date 6/1/06 Existing System Inspection by: _____ date _____

HEALTH DEPT. COPY: WHITE OWNER COPY (FINAL): YELLOW OWNER COPY (INITIAL): PINK