IREDELL COUNTY HEALTH DEPARTMENT

A ...SVILLE 704-878-5305 330.00 Paid MOORESVILLE 704-664-5281

IMPROVEMENT PERMIT / AUTHORIZATION TO CONSTRUC... / OPERATION PERMIT / EXISTING SYSTEM INSPECTION

PERMIT# 116652 PIN# 4665 98 4420 4665-97-4764 DATE 12/1/03

OWNER OR CONTRACTOR Robert & Sadie Bowers PHONE: Business 704-491-0726 Home

ADDRESS 135 Naomi Rd. Mooresville, NC

LOCATION 407 Rocky River Rd., ~ 3 divison ® past Naomi Rd. at top of hill

SUBDIVISION BLOCK / SECTION LOT LOT AREA SITE CLASS. PS DESIGN FLOW 500 L.T.A.R. .83

Septic Tank: 1000 Gallons; STB 794 Date 11/7/04

Pump Tank: 1000 Gallons; PT 27 Date 9/29/05

Pump Make: Model 2520 Serial No. 840 Acc

Nitrification Field: No Fields 1 Square Feet ~~1866~~ Linear Feet ~~600~~

No Lines 5 @ 120' Trench Width 3' Max Trench Bottom Depth 3'

☒ New System ☐ Repair System Type: I, II, (III) IV, V, VI

System Description: PM → CONVENTIONAL

Repair System Description: SAME

Maintenance Agreement Required: ☐ Yes ☒ No

Gravel Depth 12" ☒ Slab ☐ Crawl Space ☐ Basement w/plumbing ☐ Basement wo/plumbing

☐ House/Mod. Home No. Bedrooms

☐ Mobile Home No. Bathrooms

☐ Business No. Employees

☒ Other SPORTS BAR / 230 GPD.

Water Supply: ☒ Individual ☐ Public ☐ Community


Comments:/Conditions:

230 GPD - DOSE 1 TIME PER DAY MON-SAT.


Comments:/Conditions:

7 @ 120' x 3' - Shallow trench installed 49.7 GAM PM, Well Casing dispersion to tanks.

INITIAL SITE SKETCH

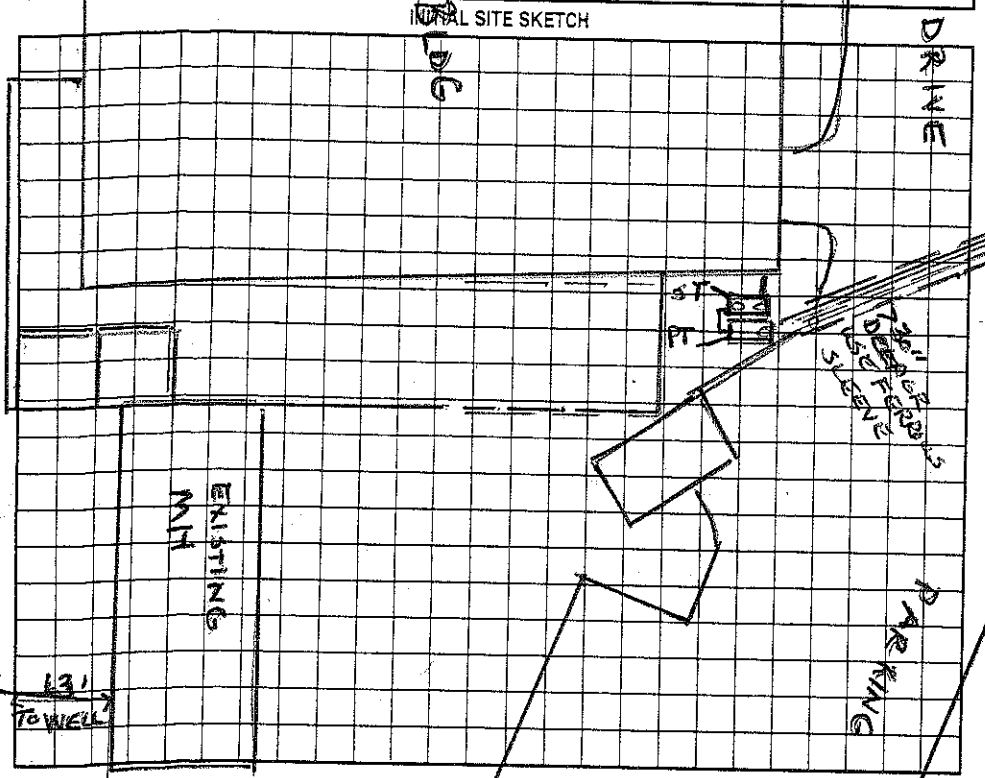

AS BUILT SKETCH

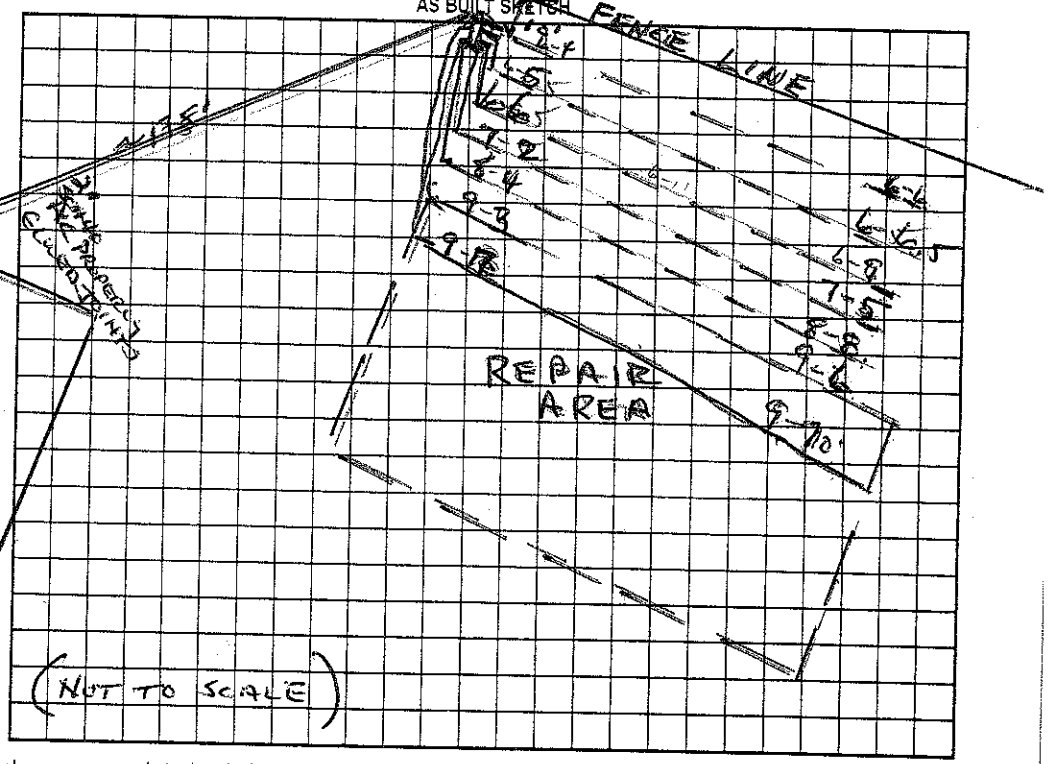

Permit can be suspended or revoked if any false information is supplied toward securing the permit/any unauthorized changes are made to the site/any unauthorized changes are made in the installation of the system. Improvement Permit with plat valid without expiration. Improvement Permit with site plan valid for sixty months. Authorization to Construct is valid for a period equal to that of Improvement Permit – not to exceed sixty months.

Signed: * Robert & Bowers date 12/1/03 Installed by: Bowers Backhoe Service

Improvement Permit by: Wesley Sparks RS. date 12/1/03 Operation Permit by: Wesley Sparks RS. date 10/3/05

Authorization to Construct by: Wesley Sparks RS date 12/1/03 Existing System Inspection by: date

HEALTH DEPT. COPY: WHITE OWNER COPY (FINAL): YELLOW OWNER COPY (INITIAL): PINK