IREDELL COUNTY HEALTH DEPARTMENT

STATESVILLE 704-878-5305 MOORESVILLE 704-664-5281

IMPROVEMENT PERMIT / AUTHORIZATION TO CONSTRUCT / OPERATION PERMIT / EXISTING SYSTEM INSPECTION

PERMIT# 127764 PIN# 4665 98 8190 DATE 8/10/05

OWNER OR CONTRACTOR Rodgerie D. Connor PHONE: Business Home 704-806-5217

ADDRESS 129 Tara Lynn Ct. Mooresville, NC. 28115

LOCATION Rocky River Rd, TL Naomi to. lots on (L) Corner

SUBDIVISION N/A BLOCK / SECTION LOT LOT AREA SITE CLASS. PS DESIGN FLOW 360 L.T.A.R. .3

Septic Tank: 1000 Gallons; STB 794 Date 9/29/05

Pump Tank: 1000 Gallons; PT 27 Date 4/5/06

Pump Make: GOULDS Model VB0311M Serial No.

Nitrification Field: No Fields 1 Square Feet 900 Linear Feet 300

No Lines 3@100 Trench Width 3' Max Trench Bottom Depth 3'

[X] New System [ ] Repair System Type: I, II, [III], IV, V, VI

System Description: Pres. Manifold - 25% Reduced

Repair System Description: Same

Maintenance Agreement Required: [ ] Yes [X] No

Gravel Depth N/A [ ] Slab [X] Crawl Space [ ] Basement w/plumbing [ ] Basement wo/plumbing

[X] House/Mod. Home No. Bedrooms 3

[ ] Mobile Home No. Bathrooms 3

[ ] Business No. Employees


[ ] Other

Water Supply: [X] Individual [ ] Public [ ] Community


Comments:/Conditions:

Comments:/Conditions: X - Supply line rerouted to road R/W and across back to Pres. Manifold. - 2" Supply line SCH 40 PVC. Original line cut off and left in the ground. AWS. 6/8/2012

INITIAL SITE SKETCH

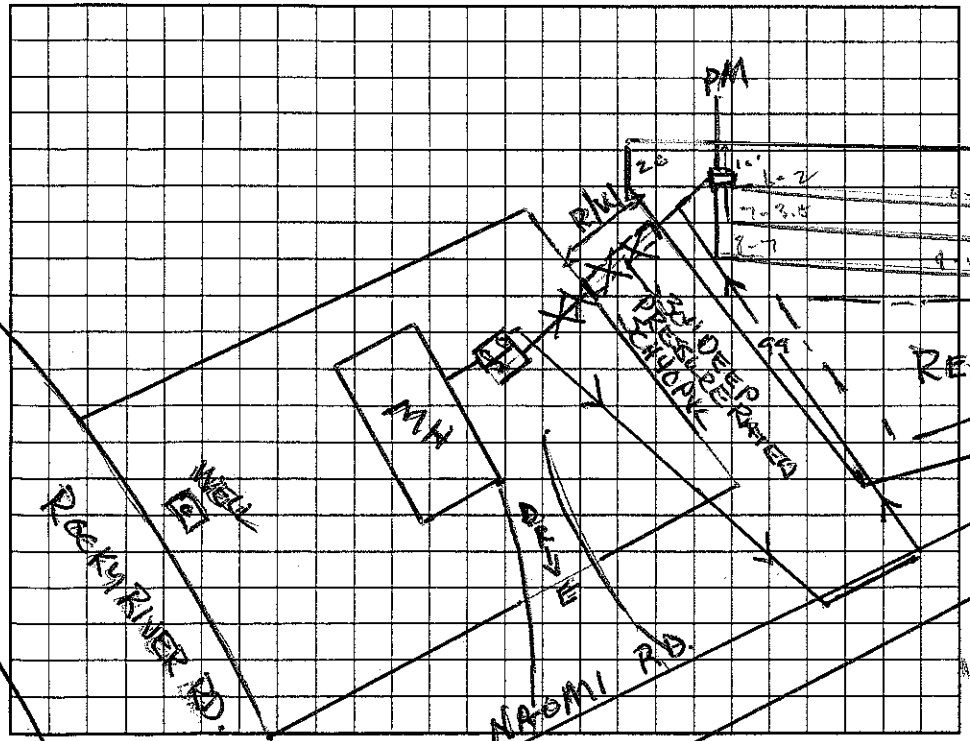

AS BUILT SKETCH

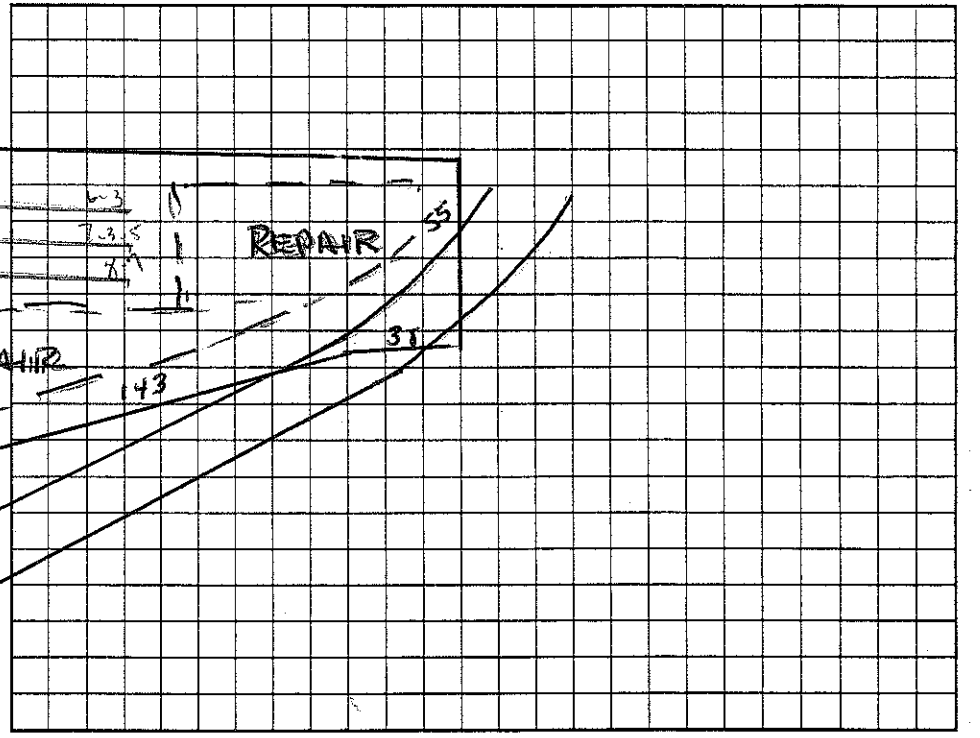

Permit can be suspended or revoked if any false information is supplied toward securing the permit/any unauthorized changes are made to the site/any unauthorized changes are made in the installation of the system. Improvement Permit with plat valid without expiration. Improvement Permit with site plan valid for sixty months. Authorization to Construct is valid for a period equal to that of Improvement Permit – not to exceed sixty months.

Signed: X Rodgerie D. Connor date

Improvement Permit by: Wesley Sparks R.S. date 8/10/05

Authorization to Construct by: Wesley Sparks R.S. date 8/10/05

Installed by: A Contractor

Operation Permit by: R.S. date 8/29/06

Existing System Inspection by: date

HEALTH DEPT. COPY: WHITE OWNER COPY (FINAL): YELLOW OWNER COPY (INITIAL): PINK