IREDELL COUNTY HEALTH DEPARTMENT

Statesville Office (704) 878-5305 Mooresville Office (704) 660-3625 PERMIT # 207612

IMPROVEMENT PERMIT / AUTHORIZATION TO CONSTRUCT / OPERATION PERMIT / EXISTING SYSTEM

PIN # 4666-00-2217

APPLICANT: CURTIS THOMPSON APPLICANT ADDRESS: 145 HAMPSHIRE DR. MOORESVILLE

SITE ADDRESS: 178 BLACKWELDER FARM RD. PHONE: 704-241-8560 ALT. PHONE:

SITE DIRECTIONS: SOUTH ON SHEARERS RD, TR BLACKWELDER FARM

SUBDIVISION: RONNIE & MELODY JOWELL PROPERTY SECTION: — LOT # 2 LOT AREA: 1 AC DESIGN FLOW: 480 L.T.A.R.: .3

Septic Tank 1000 (gal) STB 791 Date 2-17-16
Pump Tank (gal) PT Date
Pump Make Model Serial #
Nitrification Fields 1 # Lines 3C135' Linear Ft: 400'
Trench Width 36" Max. Trench Bottom Depth * 28" * Gravel Depth

☒ New System ☐ Repair ☐ Expansion System Type: I II III IV V VI
System Description: 25% REDUCTION
Repair System Description: SAME
Maintenance Agreement Required: ☐ YES ☒ NO
☒ GRAVITY ☐ PRESSURE


☒ Residence ☐ Business ☐ Other ☐ Slab
No. Bedrooms 4 No. Persons No. Employees ☒ Crawl Space
☐ Basement w/plumbing ☐ Basement w/o plumbing

Water Supply: ☒ Private ☐ Public ☐ Community

Comments / Conditions:

HOUSE BOX IS SLIGHTLY SMALLER THAN SUBMITTED HOUSE PLANS. SHOULD BE OK AS GARAGE IS BUILDER AT TOP NOT AT SEPTIC AREA.

INITIAL SITE SKETCH

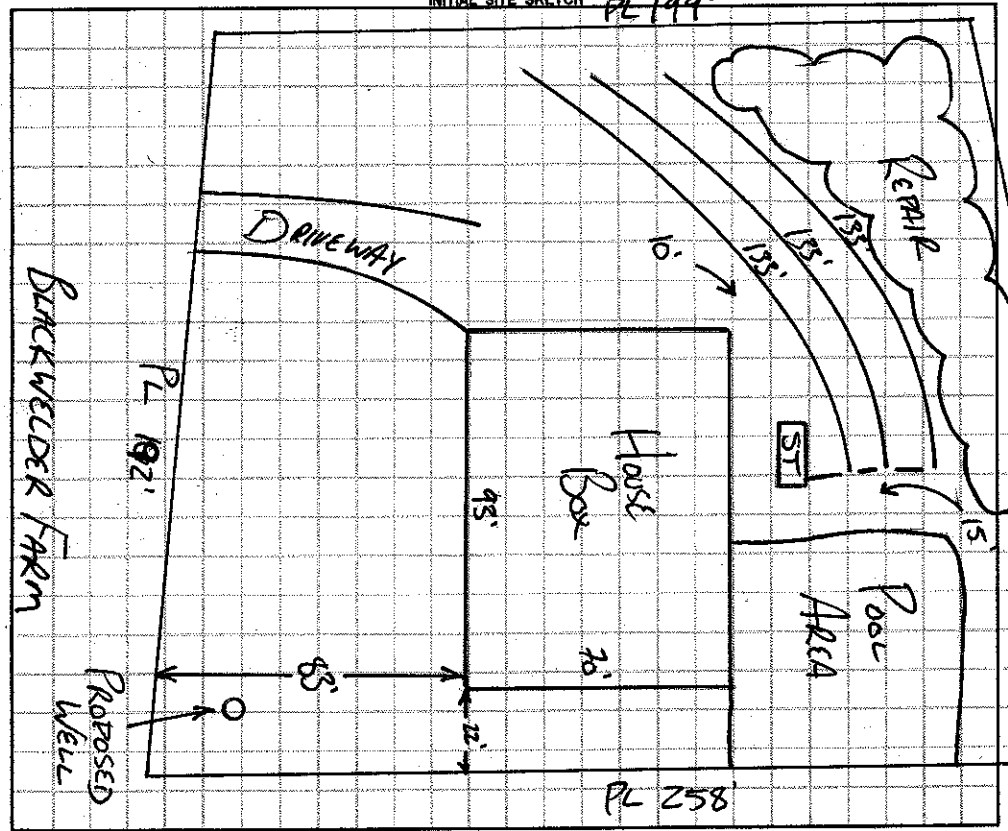

AS BUILT SKETCH

1" = 50'

SUBMITTED PLANS FOR 3332 CRAWL SPACE. NOT DOING BASEMENT. (BASEMENT HAD 4TH BEDROOM)

Permit can be suspended or revoked if any false information is supplied toward securing the permit / any unauthorized changes are made to the site / any unauthorized changes are made in the installation of the system. **CONTACT A LOCATOR SERVICE PRIOR TO ANY EXCAVATION**

☐ **IMPROVEMENT PERMIT** *with plat valid without expiration.* ☒ **IMPROVEMENT PERMIT** *with site plan valid for 60 mos.* ☒ **AUTHORIZATION TO CONSTRUCT** *valid for period equal to IMPROVEMENT PERMIT--not to exceed 60 mo.*

Owner / Applicant Signature: Curtis Thompson Date: 2/13/15 Installed by: ABERNATHY

IMPROVEMENT PERMIT by: APPROVED Date: FEB 02 2015 OPERATION PERMIT by: Date: 3-18-16

AUTHORIZATION TO CONSTRUCT by: APPROVED Date: JUN 05 2015 Existing System Inspected by: Date:

Health Dept. Copy - WHITE Applicant (Final Approval) - YELLOW Applicant (Conditional Approval) - PINK