AMP 2100

IREDELL COUNTY HEALTH DEPARTMENT

Statesville Office (704) 878-5305 Mooresville Office (704) 660-3625 PERMIT # 205468

IMPROVEMENT PERMIT / AUTHORIZATION TO CONSTRUCT / OPERATION PERMIT / EXISTING SYSTEM

PIN # 4666007726.000

APPLICANT: CHAD HOLLOWAY APPLICANT ADDRESS: 1206 GREENLAND DR. STATESVILLE, NC

SITE ADDRESS: 155 BLACKWELDER FARM DR. MOORESVILLE NC PHONE: 704-746-7094 ALT. PHONE: 704-627-4788 (OWNER)

SITE DIRECTIONS: SHEARERS RD S. TR BLACKWELDER FARM DR., SITE ON L

SUBDIVISION: — SECTION: — LOT # — LOT AREA: 1.0 ACRE DESIGN FLOW: 360 GPD L.T.A.R.: .3

Septic Tank 1000 (gal) STB 825 Date 11-4-14
Pump Tank (gal) PT Date
Pump Make Model Serial #
Nitrification Fields 1 # Lines 4 Linear Ft: 300'
Trench Width 36" Max. Trench Bottom Depth 36" Gravel Depth N/A


☑ New System ☐ Repair ☐ Expansion System Type: I II (III) IV V VI
System Description: 25% REDUCTION - GRAVITY
Repair System Description: SAME
Maintenance Agreement Required: ☐ YES ☑ NO
☑ GRAVITY ☐ PRESSURE

☑ Residence ☐ Business ☐ Other ☐ Slab ☐ Basement w/plumbing
No. Bedrooms 3 No. Persons 6 No. Employees — ☑ Crawl Space
Water Supply: ☑ Private ☐ Public ☐ Community
☐ Basement w/o plumbing


Comments / Conditions: SERIAL DISTRIBUTE 300' LINEAR FEET ON CONTOUR IN 4 LINES. USE END CAP DISTRIBUTION. MAINTAIN AT LEAST 5' FROM ANY BUILDING STRUCTURES. AND 100' FROM ANY WELL.

FOLLOW ALL SEPTIC RULES. SET 100' from house in Center Installed Quick 4 - Infiltrator Serial Distribution.

INITIAL SITE SKETCH

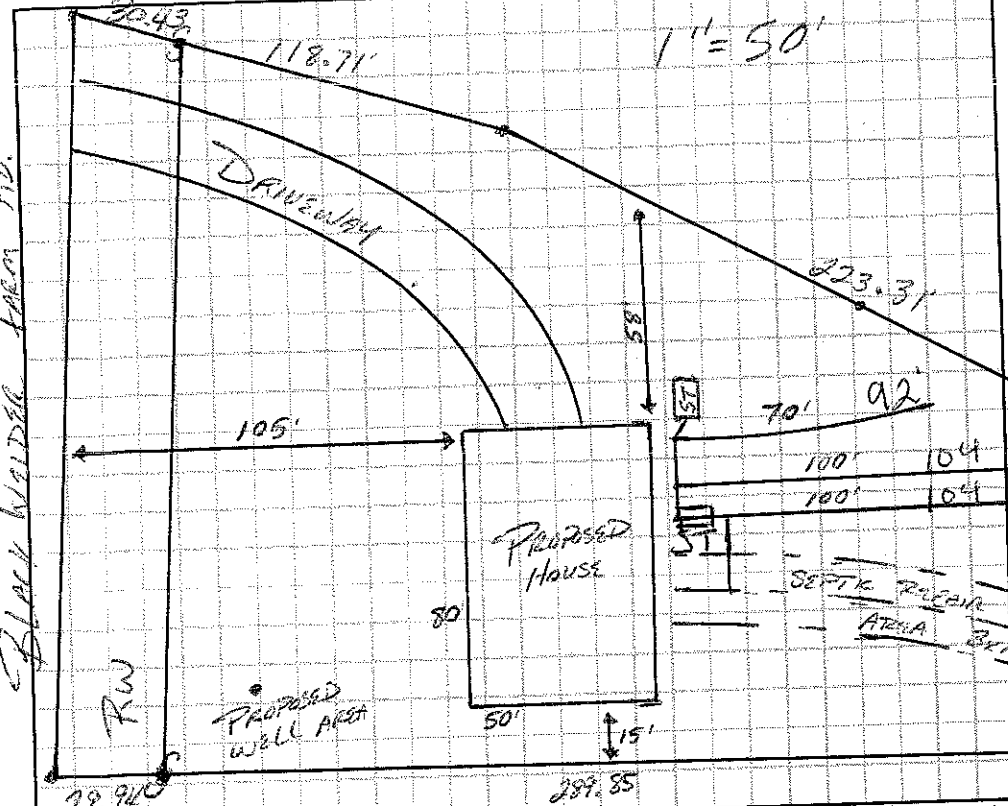

AS BUILT SKETCH

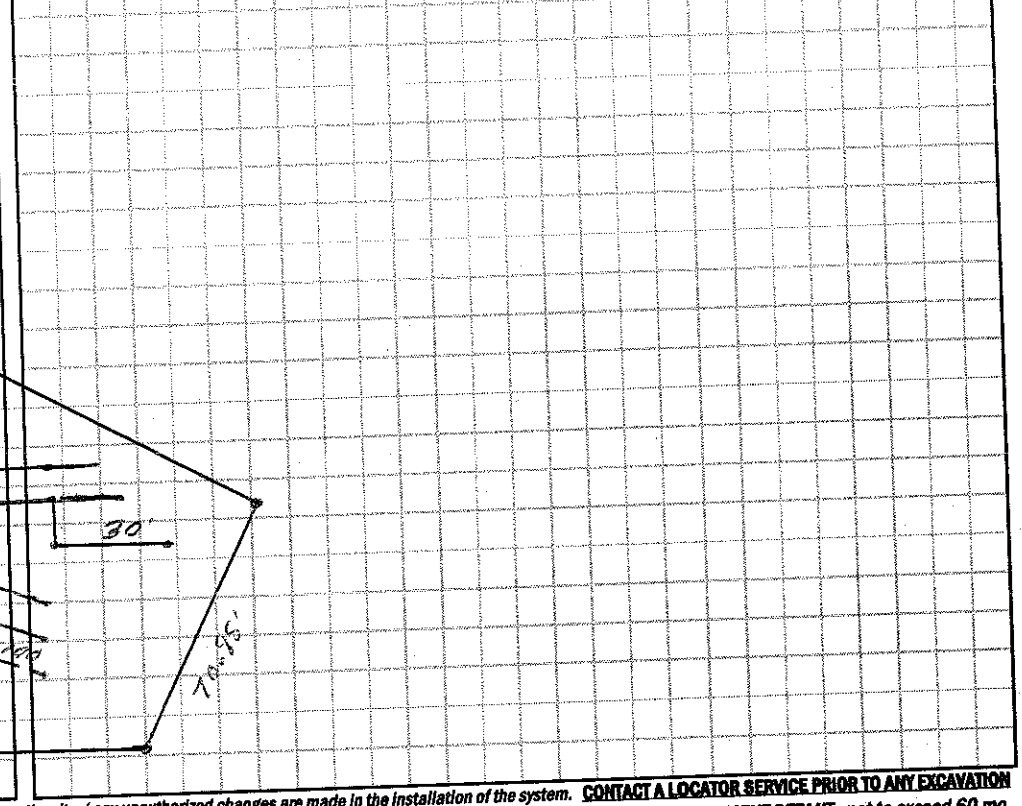

CONTACT A LOCATOR SERVICE PRIOR TO ANY EXCAVATION

Permit can be suspended or revoked if any false information is supplied toward securing the permit / any unauthorized changes are made to the site / any unauthorized changes are made in the installation of the system.

☐ **IMPROVEMENT PERMIT** *with plat valid without expiration.*

☑ **IMPROVEMENT PERMIT** *with site plan valid for 60 mos.*

☑ **AUTHORIZATION TO CONSTRUCT** *valid for period equal to IMPROVEMENT PERMIT--not to exceed 60 mo.*

Owner / Applicant Signature: Chad Holloway Date: 9/29/14

IMPROVEMENT PERMIT by: Date: 9/19/14

AUTHORIZATION TO CONSTRUCT by: Date: 9/19/14

Installed by: Rowan Septic RS Date: 12/17/14

OPERATION PERMIT by: Date:

Existing System Inspected by: Date:

Health Dept. Copy - WHITE Applicant (Final Approval) - YELLOW Applicant (Conditional Approval) - PINK