**IREDELL COUNTY HEALTH DEPAKTMENT - *ENVIRONMENTAL HEALTH*** ☐ STATESVILLE OFFICE 704-878-5305 ☒ MOORESVILLE OFFICE 704-664-5281

**IMPROVEMENT PERMIT / AUTHORIZATION TO CONSTRUCT / OPERATION PERMIT / EXISTING SYSTEM INSPECTION**

PERMIT # REPAIR PIN # 4616-03-7671 DATE 1-9-12

OWNER JAMIE BARBER APPLICANT: SAME PHONE: Home/Cell # 704-804-6403 Business #

SITE ADDRESS 872 SHEARERS RD OWNER / APPLICANT ADDRESS SAME

SITE DIRECTIONS SAME


SUBDIVISION — BLOCK / SECTION — LOT # — LOT AREA 1.497 AC DESIGN FLOW 240 GPD L.T.A.R. .3

| | | | | | | | | | |
|---|---|---|---|---|---|---|---|---|---|
| Septic Tank 1000 | Gallons: STB 794 | Date 8-19-11 | ☐ New System | ☒ Repair | ☐ Expansion System | Type I II (III) IV V VI | ☒ Residence | No. Bedrooms 2 | Water Supply |
| Pump Tank | Gallons: P T | Date | System Description: | | | 25% | ☐ Business | No. Persons | ☒ Private |
| Pump Make | Model | Serial # | Repair System Description: | | | | ☐ Other | No. Employees | ☐ Public |
| No. Nitrification Fields: 1 | No. Lines 3 | Linear Feet 200' | Maintenance Agreement Required | ☐ YES | ☒ NO | | ☐ Slab | ☒ Crawl Space | ☐ Community |
| Trench Width 36" | Max. Trench Bottom Depth ~~28"~~ | | Gravel Depth 756 | ☒ GRAVITY | ☐ PRESSURE | | ☒ Basement w/plumbing | ☐ Basement w/o plumbing | |


Comments / Conditions

① KEEP TANK & LINES 15' MIN FROM BASEMENT

INITIAL SITE SKETCH

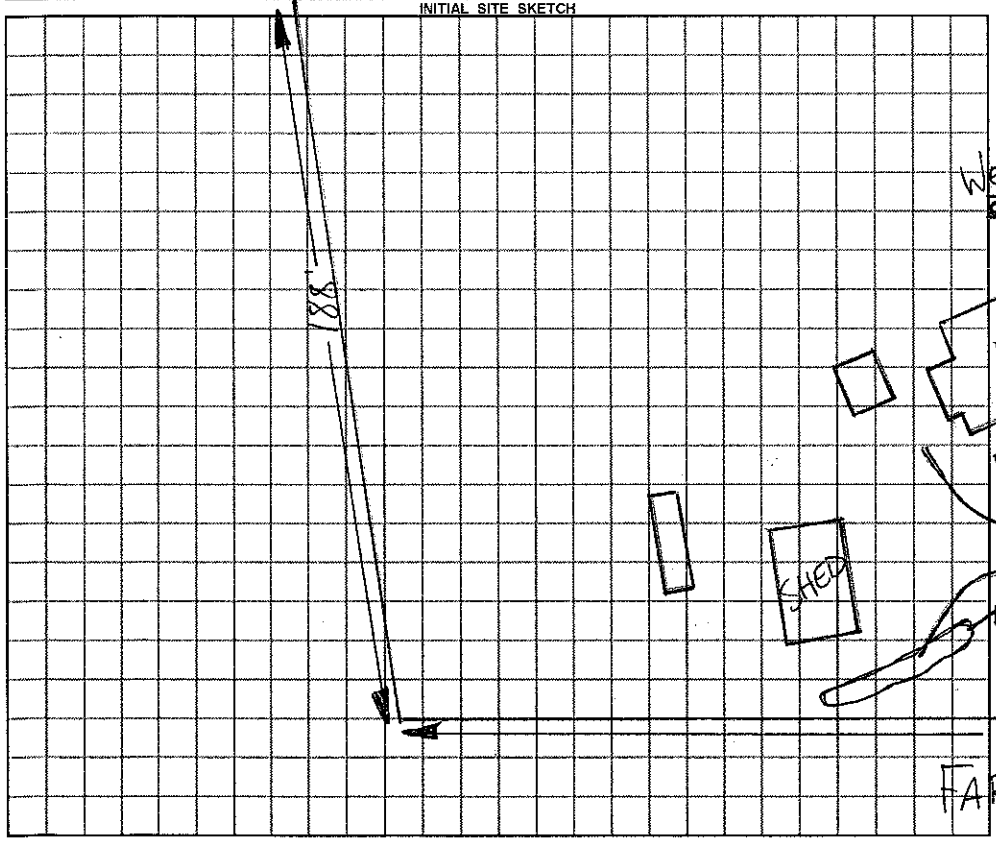


AS BUILT SKETCH

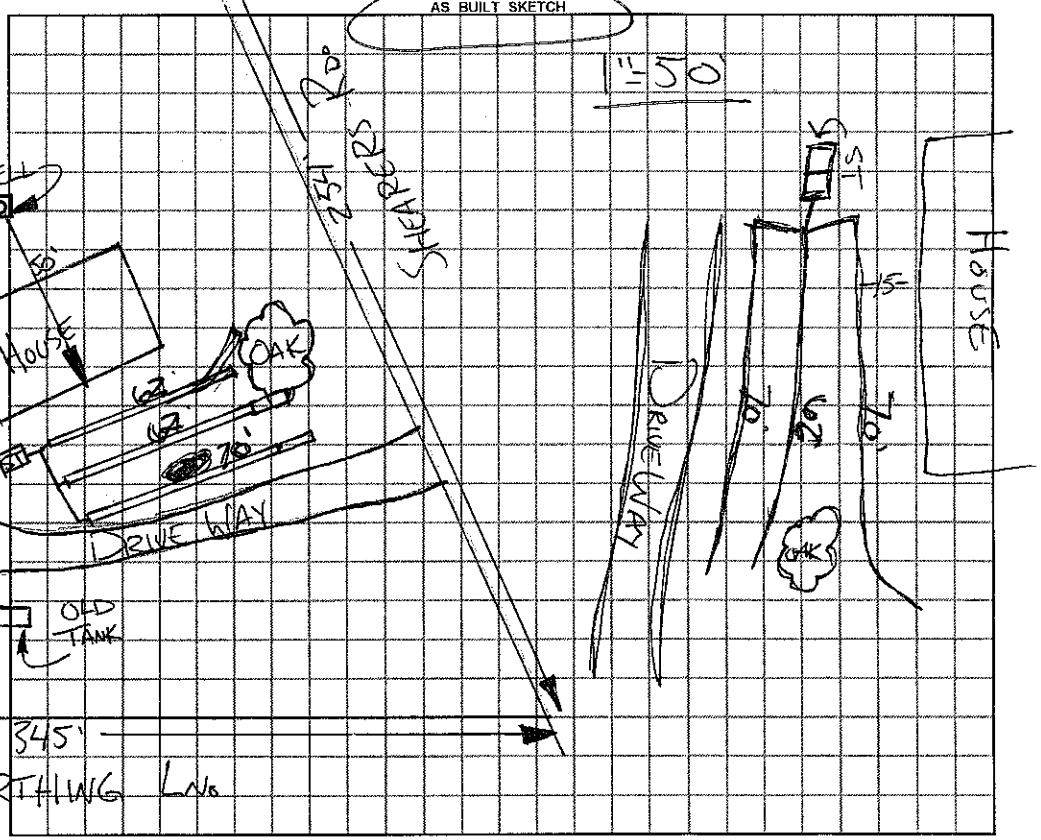


*Permit can be suspended or revoked if any false information is supplied toward securing the permit / any unauthorized changes are made to the site / any unauthorized changes are made in the installation of the system.*

☐ ***IMPROVEMENT PERMIT*** with plat valid without expiration. ☐ ***IMPROVEMENT PERMIT*** with plat valid without expiration. site plan valid 60 mo. ☒ ***AUTHORIZATION TO CONSTRUCT*** valid for period equal to IMPROVEMENT PERMIT--not to exceed 60 mo.

Owner / Applicant Signature: Jamie Barber Russell Little Date 1-12-12

IMPROVEMENT PERMIT by: REHS Date 1-9-12

AUTHORIZATION TO CONSTRUCT by: REHS Date 1-9-12

***YOU SHOULD CONTACT A LOCATOR SERVICE PRIOR TO ANY EXCAVATION***

Installed by: WASTEWATER SOLUTIONS

OPERATION PERMIT by: REHS Date 1-19-17

Existing System Inspected by: REHS Date

White Copy – Environmental Health YELLOW COPY (Final) Owner / Applicant PINK COPY (Initial) Owner / Applicant