IREDELL COUNTY HEALTH DEPARTMENT

Authorization to Construct ✓ 10:30

STATESVILLE 704-878-5305 MOORESVILLE 704-664-5281

IMPROVEMENT PERMIT / CERTIFICATE OF COMPLETION / OPERATION PERMIT / EXISTING SYSTEM INSPECTION

PROPERTY DESCRIPTION NO. 3890 - Mooresville Jurisdiction DATE 5/3/96 TAX MAP NO. pt of 15A15 Watershed: ☐ Yes ☑ No

OWNER OR CONTRACTOR David Huffman PHONE: Business 664-1383 Home 663-2671

ADDRESS 459 Hager Rd Mooresville, NC 28115

LOCATION (Across from #124) Shears Rd - TR Clod Felker Lot on left 4666604093 1

SUBDIVISION Alvin Brown BLOCK / SECTION ____ LOT 3 LOT AREA .7 ac SITE CLASS. PS DESIGN FLOW 360 gpd L.T.A.R. .3 gpd/ft²

Septic Tank: 1000 Gallons; STB ____ Date 2/6/96

Pump Tank: ____ Gallons; PT ____ Date ____

Pump Make: ____ Model ____ Serial No. ____

Nitrification Field: No Fields 1 Square Feet 1200 Linear Feet 400

No Lines 4 Trench Width 36" Max Trench Bottom Depth 36" Gravel Depth 12"

☑ New System ☐ Repair System Type: I II III IV V VI

System Description: Gravity Conventional

Repair System Description: Same

Maintenance Agreement Required: ☐ Yes ☑ No

☑ House/Mod. Home No. Bedrooms 3

☐ Mobile Home No. Bathrooms 2.5

☐ Business No. Employees ____

☐ Other ____


☐ Slab ☑ Crawl Space ☐ Basement w/plumbing ☐ Basement wo/plumbing

Water Supply: ☑ Individual ☐ Community ☐ Public


Comments:

Comments:

INITIAL SITE SKETCH 15

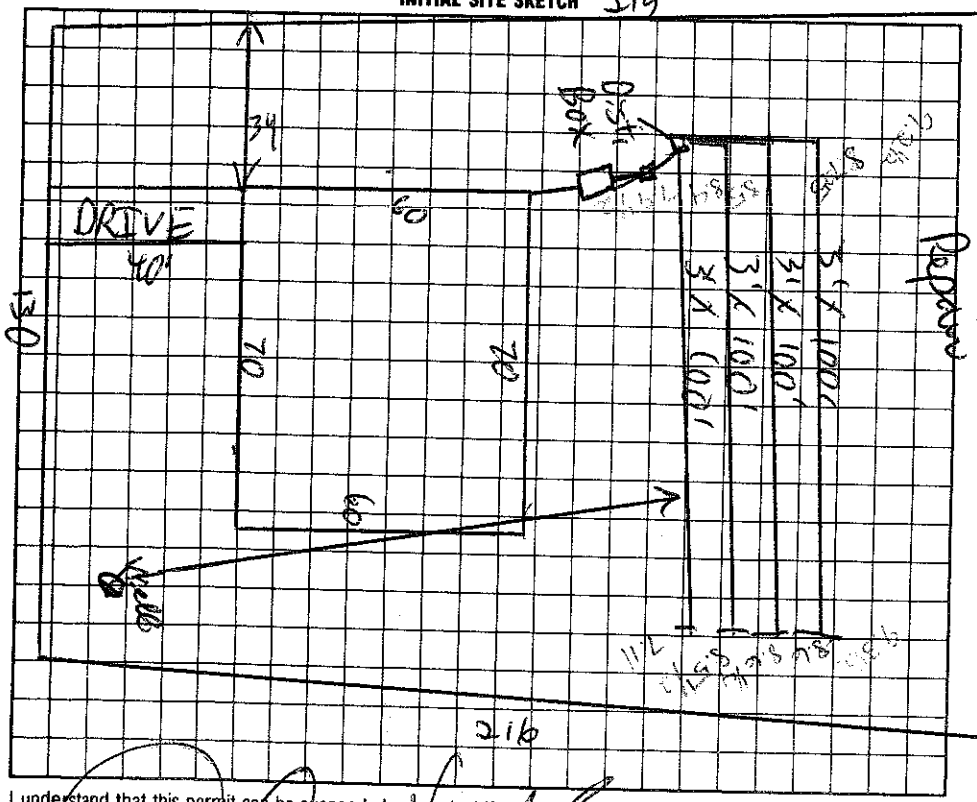

AS BUILT SKETCH

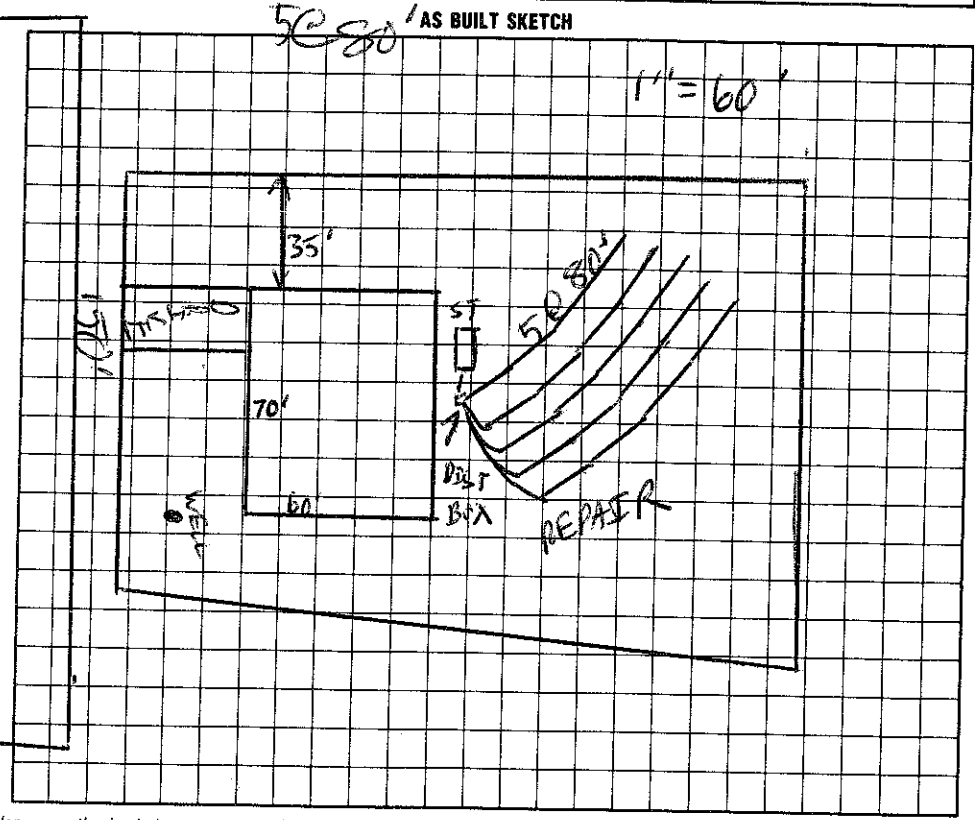

I understand that this permit can be suspended or revoked if any false information is supplied toward securing the permit/any unauthorized changes are made to the site/any unauthorized changes are made in the installation of the system.

Signed ____

Improvement Permit by: C. Rudy Green EHSI date 5/3/96

Authorization to Construct — Existing System Inspection by: C. Rudy Green EHSI date 5/3/96

Installed by: FJ ELVIN

Certificate of Completion by: ____ date ____

Operation Permit by: C. Rudy Green EHSI date 3/7/97

HEALTH DEPT. COPY: WHITE INSPECTION COPY (FINAL): GREEN OWNER COPY (FINAL): YELLOW INSPECTION COPY (INITIAL): PINK OWNER COPY (INITIAL): GOLD

Authorization to Construct is valid for 60 days from date of issuance.