3:01

IREDELL COUNTY HEALTH DEPARTMENT

STATESVILLE 704-878-5305 MOORESVILLE 704-664-5281

IMPROVEMENT PERMIT / AUTHORIZATION TO CONSTRUCT / OPERATION PERMIT / EXISTING SYSTEM INSPECTION

PERMIT # REPAIR PIN # 4666-11-6889 DATE 1-11-10

OWNER or APPLICANT Tim PERRY PHONE: Business 980-521-8778 Home:

OWNER or APPLICANT ADDRESS 965 SHEARERS RD

LOCATION / DIRECTIONS

SUBDIVISION — BLOCK / SECTION — LOT # — LOT AREA .84 AC DESIGN FLOW 240 GPD L.T.A.R. .3

Septic Tank EXISTING Gallons: STB Date

Pump Tank Gallons: P T Date

Pump Make Model Serial #

Nitrification Field No Fields 1 No Lines 3 Linear Feet 204'

Trench Width 36" Max. Trench Bottom Depth 24" Gravel Depth —

☐ New System ☒ Repair ☐ Expansion System Type I (II) III IV V VI

System Description:

Repair System Description: GRAVITY 25% REDUCTION

Maintenance Agreement Required ☐ YES ☒ NO

☐ GRAVITY ☐ PRESSURE


☒ Residence No. Bedrooms 2 ☐ Business No. Persons ☐ Other No. Employees ☐ Slab ☒ Crawl Space ☐ Basement w/plumbing ☐ Basement w/o plumbing

Water Supply: ☒ Private ☐ Public ☐ Community


Comments / Conditions USE 24" TRENCH BOTTOM TO STAY 12" ABOVE SAPROLITE

Comments / Conditions Installed Quick 4 as Shown Old Field Cut off

INITIAL SITE SKETCH

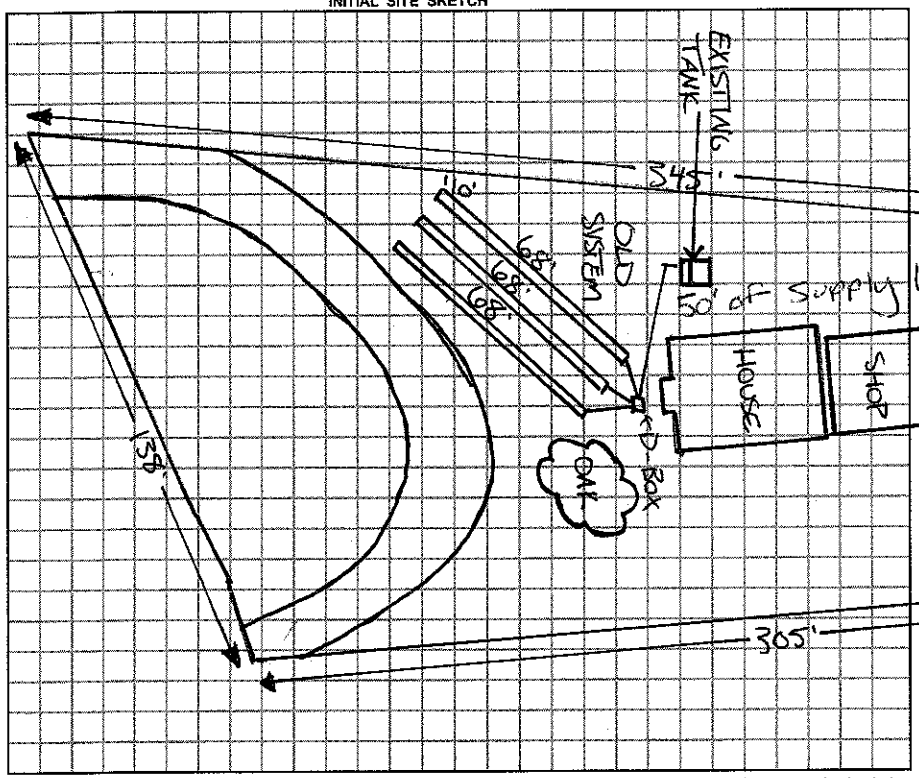

AS BUILT SKETCH

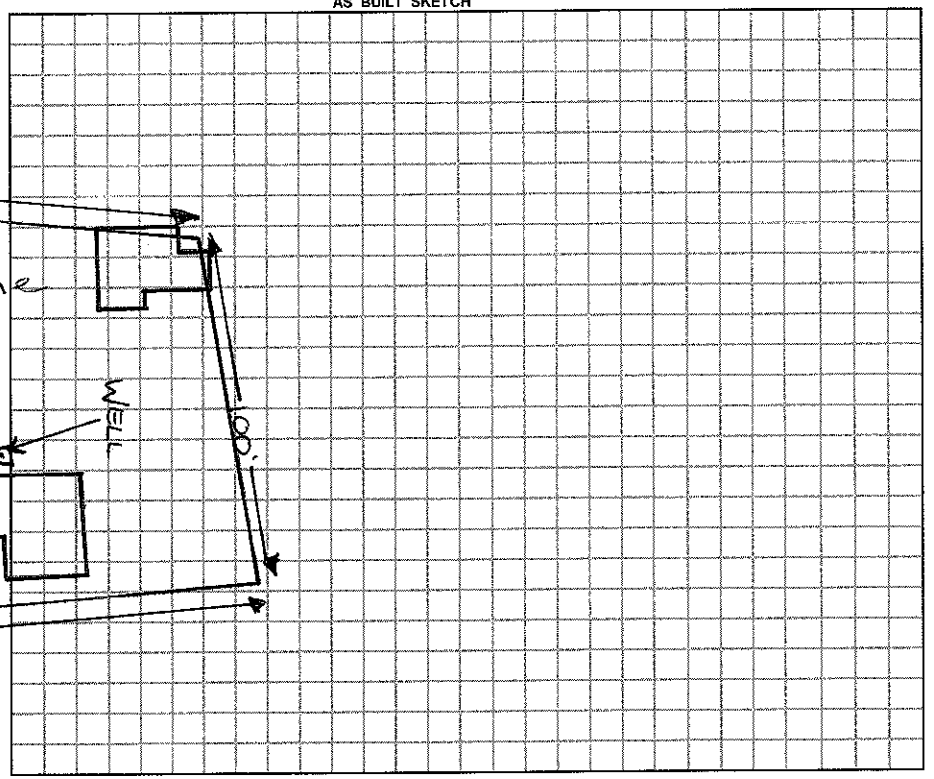

Permit can be suspended or revoked if any false information is supplied toward securing the permit / any unauthorized changes are made to the site / any unauthorized changes are made in the installation of the system.

☐ *IMPROVEMENT PERMIT w / plat valid without expiration.* ☐ *IMPROVEMENT PERMIT w / site plan valid for 60 mos.* ☒ *AUTHORIZATION TO CONSTRUCT valid for period equal to IMPROVEMENT PERMIT not to exceed 60 mo.*

Owner / Applicant Signature: Tim Perry Date 1/13/10

Improvement Permit by: B. A. Ellis REHS Date 1-11-10

Authorzation to Construct by: B. A. Ellis REHS Date 1-11-10

YOU SHOULD CONTACT A LOCATOR SERVICE PRIOR TO ANY EXCAVATION.

Installed by: Wastewater Solutions & Design

Operation Permit by: Marie Dotson RS Date: 1/19/2010

Existing System Inspected by: Date:

WHITE COPY Environmental Health YELLOW COPY (Final) Owner / Applicant PINK COPY (Initial) Owner / Applicant