IREDELL COUNTY HEALTH DEPARTMENT

STATESVILLE 704-878-5305 MOORESVILLE 704-664-5281

IMPROVEMENT PERMIT / AUTHORIZATION TO CONSTRUCT / OPERATION PERMIT / EXISTING SYSTEM INSPECTION

PERMIT# 7531 PIN# 4666 39 5214 DATE 4/25/00

OWNER OR CONTRACTOR John & Susan Davis PHONE: Business Home 664-4812

ADDRESS 2943 Charlotte Hwy, Mooresville, NC 28115

LOCATION Magnolia St. TR on Ridgecrest TL on Hickory Ln. to 2nd house on (R)

SUBDIVISION FERGUSON BLOCK / SECTION LOT 3 LOT AREA ~2.62 Ac SITE CLASS. PS DESIGN FLOW 480 L.T.A.R. .3

Septic Tank: 1000 Gallons; STB 994 Date 8/25/00
Pump Tank: Gallons; PT Date
Pump Make: Model Serial No.
Nitrification Field: No Fields 1 Square Feet 1200 Linear Feet 400
No Lines 4@67'x3' Trench Width 36" Max Trench Bottom Depth 36" Gravel Depth SAND

☒ New System ☐ Repair System Type: I, II, (III), IV, V, VI
System Description: Gravity - HDS or CH. Plastic
Repair System Description: Same
Maintenance Agreement Required: ☐ Yes ☐ No


☒ House/Mod. Home No. Bedrooms 4
☐ Mobile Home No. Bathrooms 3
☐ Business No. Employees
☐ Other
☐ Slab ☒ Crawl Space ☐ Basement w/plumbing ☐ Basement wo/plumbing

Water Supply: ☒ Individual ☐ Public ☐ Community


Comments:/Conditions:

Comments:/Conditions:

INITIAL SITE SKETCH

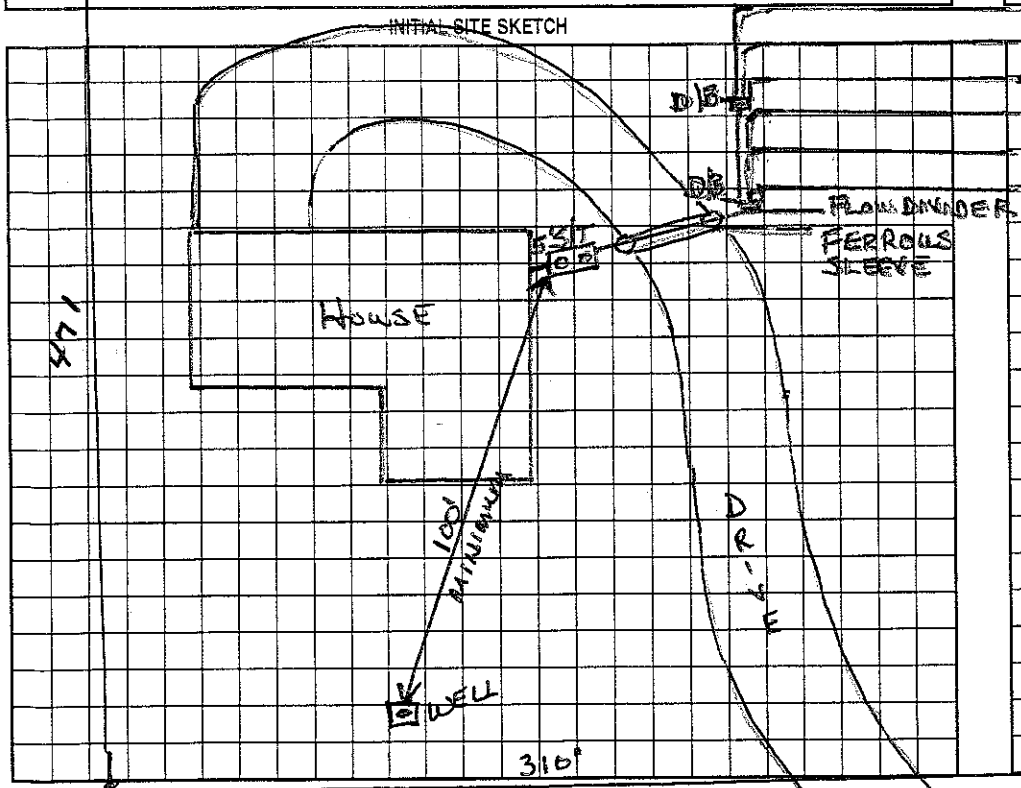

AS BUILT SKETCH

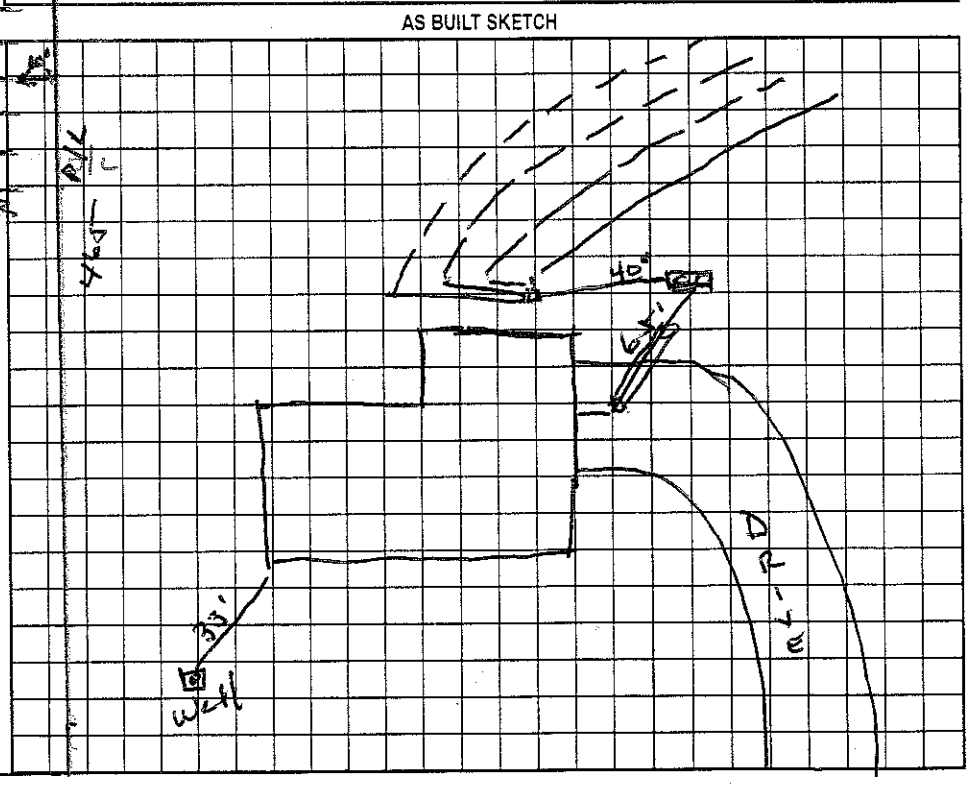

Permit can be suspended or revoked if any false information is supplied toward securing the permit/any unauthorized changes are made to the site/any unauthorized changes are made in the installation of the system. Improvement Permit with plat valid without expiration. Improvement Permit with site plan valid for sixty months. Authorization to Construct is valid for a period equal to that of Improvement Permit – not to exceed sixty months.

Signed: * Kelly Caudill date

Improvement Permit by: Wesley Sparks RS. date 4/25/00

Authorization to Construct by: Wesley Sparks RS. date 4/25/00

Installed by: Larry Beam

Operation Permit by: Wesley Sparks RS. date 10/4/00

Existing System Inspection by: date

HEALTH DEPT. COPY: WHITE OWNER COPY (FINAL): YELLOW OWNER COPY (INITIAL): PINK