IREDELL COUNTY HEALTH DEPARTMENT

STATESVILLE 704-878-5305 MOORESVILLE 704-664-5281

IMPROVEMENT PERMIT / AUTHORIZATION TO CONSTRUCT / OPERATION PERMIT / EXISTING SYSTEM INSPECTION

PERMIT # 15606 12 PIN # 4666656075 79 DATE 7/28/09

OWNER or APPLICANT V & B Construction / Travis Kucipil PHONE: Business 704. 507.6232 Home: *704.507.1285

OWNER or APPLICANT ADDRESS 191 Twin Cedars Golf Rd. Mocksville, NC 27028

LOCATION / DIRECTIONS Hwy 3 East, TR Kam, TL Franklin, on Rt. (132 sagewood Dr.)

SUBDIVISION — BLOCK / SECTION — LOT # — LOT AREA 16,473 sq ft DESIGN FLOW 100 gpd L.T.A.R. 0.25

Septic Tank 1000 Gallons: STB 794 Date 10-8-09

Pump Tank — Gallons: P T Date —

Pump Make — Model — Serial # —

Nitrification Field No Fields 1 No Lines 1 Linear Feet 100

Trench Width 36" Max. Trench Bottom Depth 36" Gravel Depth — GRAVITY PRESSURE

☑ New System ☐ Repair ☐ Expansion System Type I II III IV V VI

System Description: Gravity 25%

Repair System Description: gravity 25%

Maintenance Agreement Required ☐ YES ☑ NO


☐ Residence No. Bedrooms — ☐ Business No. Persons — ☑ Other No. Employees — ☑ Slab ☐ Crawl Space ☐ Basement w/plumbing ☐ Basement w/o plumbing

Water Supply: ☑ Private ☐ Public ☐ Community

Comments / Conditions
* Install on Contour / Maintain all setbacks
* System only for 1 bathroom for employees in garage
* Surface water diversion ditch 20' above system
* ~~Side cut for~~

Comments / Conditions
* grade above line for positive drainage
* Have installer call to meet Env. Health Staff to discuss installation. (Preferably Randell Moore)

INITIAL SITE SKETCH

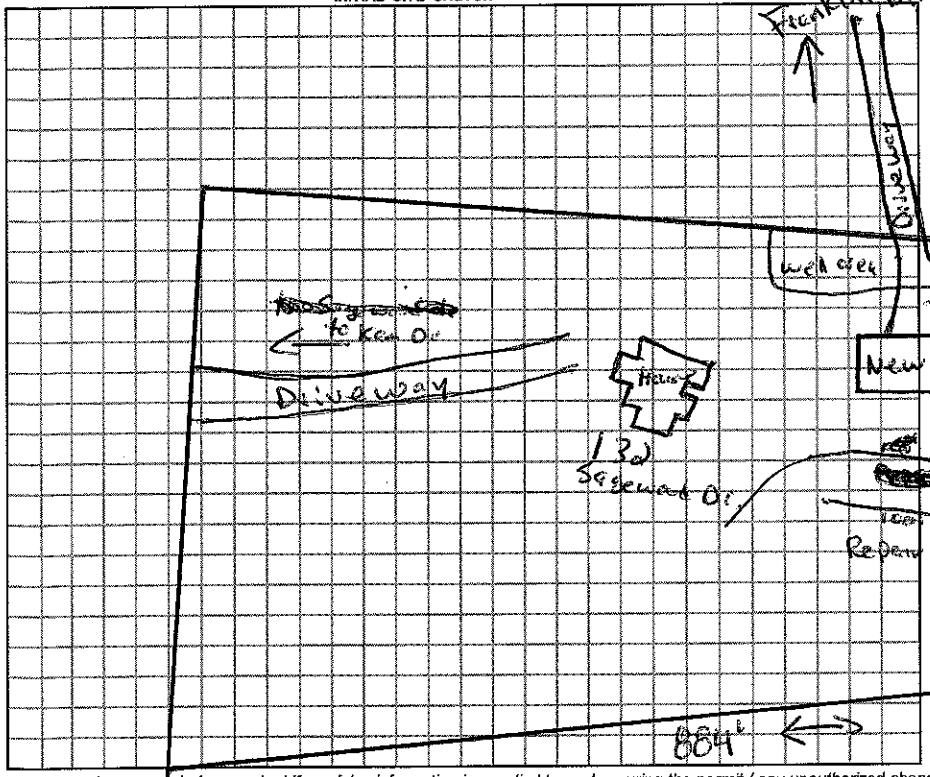

AS BUILT SKETCH

* CITY SEWER LINE HIT DURING INSTALLATION. MET WITH MARK FROM TOWN. NEED TO SEAL W/ HYDROLIC CEMENT IN 2 SEPERAT PLACES. SEWER LINE NO LONGER USED

CHECKED TANK 9-2-09

* INSTALLED AS SHOWN

Permit can be suspended or revoked if any false information is supplied toward securing the permit / any unauthorized changes are made to the site / any unauthorized changes are made in the installation of the system.

☐ *IMPROVEMENT PERMIT w / plat valid without expiration.* ☑ *IMPROVEMENT PERMIT w / site plan valid for 60 mos.* ☑ *AUTHORIZATION TO CONSTRUCT valid for period equal to IMPROVEMENT PERMIT-not to exceed 60 mo.*

Owner / Applicant Signature: [signature] Date 8/20/09

Improvement Permit by: [signature] Date 7/28/09

Authorization to Construct by: [signature] Date 7/28/09

Installed by: LARRY BEAM GRADING

Operation Permit by: [signature] RS Date: 9-3-09

Existing System Inspected by: — Date: —

YOU SHOULD CONTACT A LOCATOR SERVICE PRIOR TO ANY EXCAVATION.

WHITE COPY Environmental Health YELLOW COPY (Final) Owner / Applicant PINK COPY (Initial) Owner / Applicant