4/16/97 2:30

IREDELL COUNTY HEALTH DEPARTMENT

Authorization to Construct

STATESVILLE 704-878-5305 MOORESVILLE 704-664-5281

IMPROVEMENT PERMIT / ~~CERTIFICATE OF COMPLETION~~ / OPERATION PERMIT / EXISTING SYSTEM INSPECTION

PROPERTY DESCRIPTION NO. 4026 DATE 8/15/96 TAX MAP NO. 1E A 74 Watershed: ☐ Yes ☒ No

OWNER OR CONTRACTOR Donna Bowles PHONE: Business _____ Home 663-0491

ADDRESS 154 Kistler Rd. Mooresville, NC. 28115

LOCATION Kistler Rd. ~ .2 mile on (R) past #154

SUBDIVISION N/A BLOCK / SECTION N/A LOT _____ LOT AREA ~ 2Ac SITE CLASS PS DESIGN FLOW 360 L.T.A.R. .35

Septic Tank: 1000 Gallons; STB 794 Date 3-11-97

Pump Tank: _____ Gallons; PT _____ Date _____

Pump Make: _____ Model _____ Serial No. _____

Nitrification Field: No Fields 1 Square Feet 1440 Linear Feet 480

No Lines 4 Trench Width 36" Max Trench Bottom Depth 30" Gravel Depth 12"

☒ New System ☐ Repair System Type: I, (II), III, IV, V, VI

System Description: CONV - DIST BOX

Repair System Description: Modified (pump)

Maintenance Agreement Required: ☐ Yes ☐ No

☒ House/Mod. Home ☐ Mobile Home ☐ Business ☐ Other

No. Bedrooms 3 No. Bathrooms 2 No. Employees _____


☐ Slab ☐ Crawl Space ☒ Basement w/plumbing ☐ Basement wo/plumbing

Water Supply: ☒ Individual ☐ Community ☐ Public


Comments: Speed levelers on all trenchlines Lines on slope contour in direction shown.

Comments: Installed as shown

INITIAL SITE SKETCH P/L

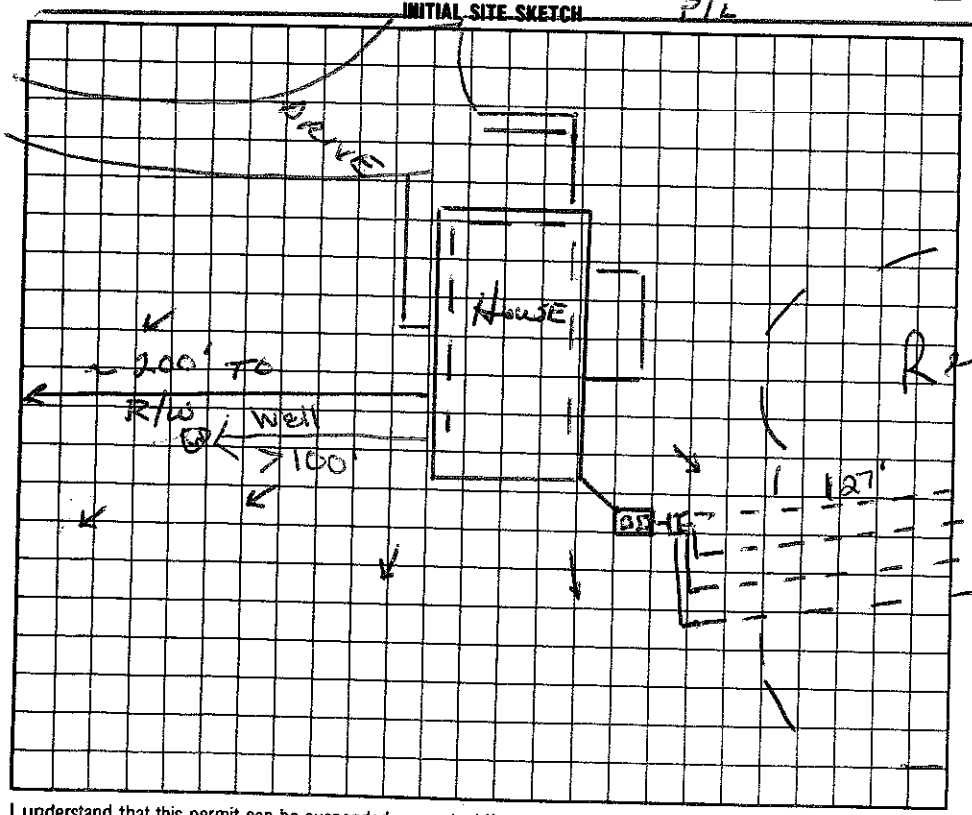

AS BUILT SKETCH

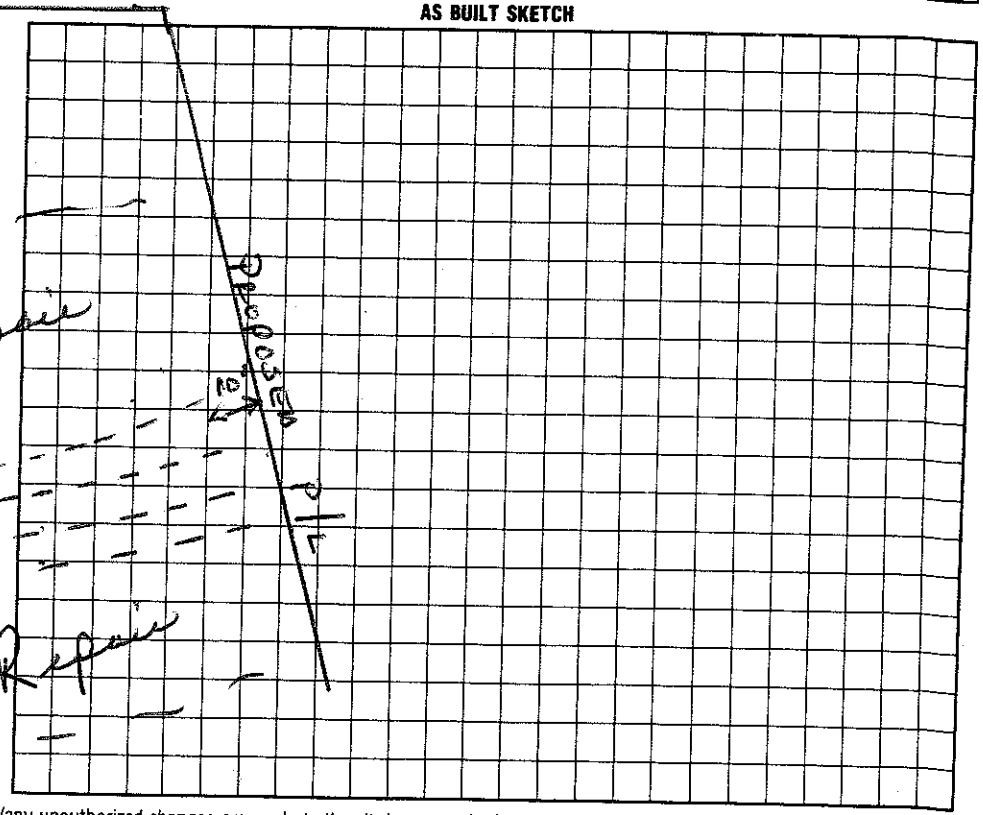

I understand that this permit can be suspended or revoked if any false information is supplied toward securing the permit/any unauthorized changes are made to the site/any unauthorized changes are made in the installation of the system.

Signed: Authorization to Construct valid 6 months, Donna Bowles

Improvement Permit by: Wesley Sparks RS. date 8/15/96

~~Authorization to Construct~~ Existing System Inspection by: Wesley Sparks RS date 8/15/96

Installed by: Larry Beam

Certificate of Completion by: Maint. H. Dotson date 6/4/97

Operation Permit by: Maint. H. Dotson date 6/4/97

HEALTH DEPT. COPY: WHITE INSPECTION COPY (FINAL): GREEN OWNER COPY (FINAL): YELLOW INSPECTION COPY (INITIAL): PINK OWNER COPY (INITIAL): GOLD