IREDELL COUNTY HEALTH DEPARTMENT

STATESVILLE 704-878-5305 MOORESVILLE 704-664-5281

IMPROVEMENT PERMIT / AUTHORIZATION TO CONSTRUCT / OPERATION PERMIT / EXISTING SYSTEM INSPECTION

PERMIT# Repair PIN# 4666-65-5925 DATE

OWNER OR CONTRACTOR Carmen Hamilton PHONE: Business Home 704-663-6411

ADDRESS 133 Franklin Dr Mooresville NC 28115

LOCATION Hwy 3 South, TR Franklin Dr, on Lt

SUBDIVISION Four Oaks BLOCK / SECTION LOT 7-9 LOT AREA SITE CLASS. PS DESIGN FLOW 720 L.T.A.R. —

Septic Tank: 1500 Gallons; STB 1014 Date 4/11/04

Pump Tank: Gallons; PT Date

Pump Make: Model Serial No.

Nitrification Field: No Fields Square Feet Linear Feet

No Lines Trench Width Max Trench Bottom Depth Gravel Depth

☐ New System ☒ Repair System Type: I, II, III, IV, V, VI

System Description:

Repair System Description: Existing 25% Reduct

Maintenance Agreement Required: ☐ Yes ☒ No

☒ House/Mod. Home No. Bedrooms 6

☐ Mobile Home No. Bathrooms

☐ Business No. Employees

☐ Other

☐ Slab ☒ Crawl Space ☐ Basement w/plumbing ☐ Basement wo/plumbing

Water Supply: ☒ Individual ☐ Public ☐ Community


Comments:/Conditions:

Replace Existing Tank

Comments:/Conditions:

Original in 1998 - Hamilton

INITIAL SITE SKETCH

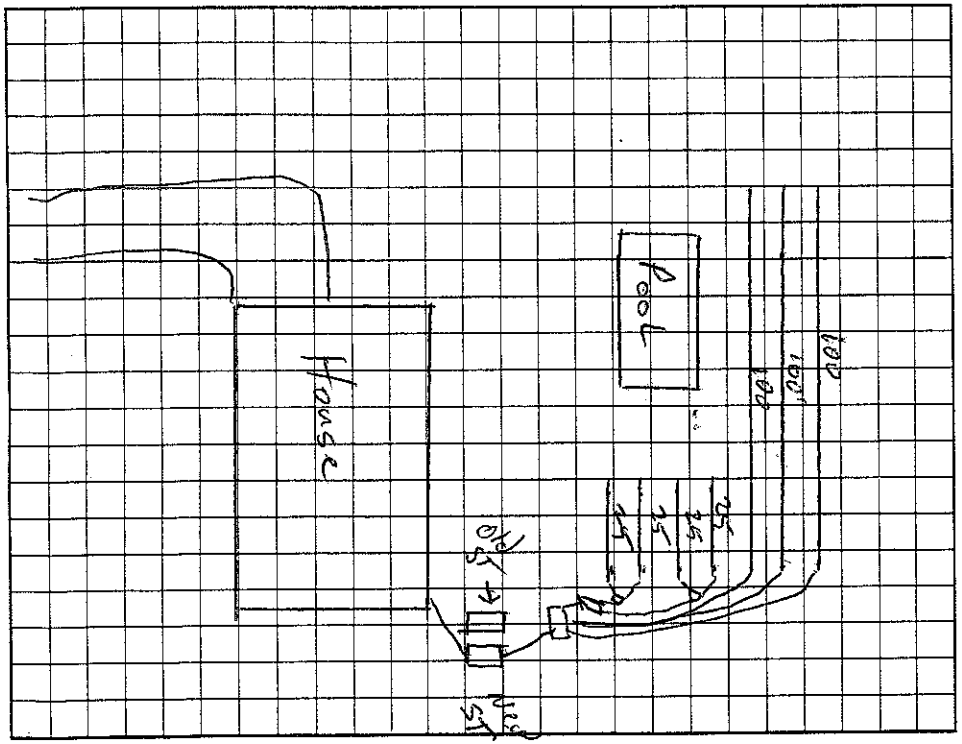

AS BUILT SKETCH

Permit can be suspended or revoked if any false information is supplied toward securing the permit/any unauthorized changes are made to the site/any unauthorized changes are made in the installation of the system. Improvement Permit with plat valid without expiration. Improvement Permit with site plan valid for sixty months. Authorization to Construct is valid for a period equal to that of Improvement Permit – not to exceed sixty months.

Signed: Carmen Hamilton date 8/5/04

Improvement Permit by: RS date 8/5/04

Authorization to Construct by: RS date 8/5/04

Installed by: Tim Ammons

Operation Permit by: RS date 8/6/04

Existing System Inspection by: date

HEALTH DEPT. COPY: WHITE OWNER COPY (FINAL): YELLOW OWNER COPY (INITIAL): PINK