IREDELL COUNTY HEALTH DEPARTMENT - **ENVIRONMENTAL HEALTH** ☐ STATESVILLE OFFICE 704-878-5305 ☒ MOORESVILLE OFFICE 704-664-5281

IMPROVEMENT PERMIT / AUTHORIZATION TO CONSTRUCT / OPERATION PERMIT / EXISTING SYSTEM INSPECTION

PERMIT # 17501 PIN # 4666-65-6959 DATE 6-7-12

OWNER SUE LAWSON APPLICANT: ERIC WARD

SITE ADDRESS PHONE: Home/Cell # Business #

SITE DIRECTIONS HWY 3 TO FRANKLIN, 2ND ON LEFT OWNER / APPLICANT ADDRESS 1124 CHARLOTTE HWY

SUBDIVISION FOUR OAKS BLOCK / SECTION LOT # 5&6 LOT AREA .65AC

Septic Tank 1000 Gallons: STB 760 Date 7-14 ☒ New System ☐ Repair ☐ Expansion System Type I II (III) IV V VI DESIGN FLOW 360 L.T.A.R. .3

Pump Tank Gallons: P T Date System Description: GRAVITY 25%

Pump Make Model Serial # Repair System Description: SAME

No. Nitrification Fields: 1 No. Lines 5 Linear Feet 300 Maintenance Agreement Required ☐ YES ☒ NO

Trench Width 36" Max. Trench Bottom Depth 26" Gravel Depth — ☒ GRAVITY ☐ PRESSURE

☒ Residence No. Bedrooms 3 Water Supply ☒ Private

☐ Business No. Persons ☐ Public

☐ Other No. Employees ☐ Community

☐ Slab ☒ Crawl Space


☐ Basement w/plumbing ☐ Basement w/o plumbing

Comments / Conditions


*Maximum feasible distance btw ST & well was 77ft.

INITIAL SITE SKETCH

1"=40'

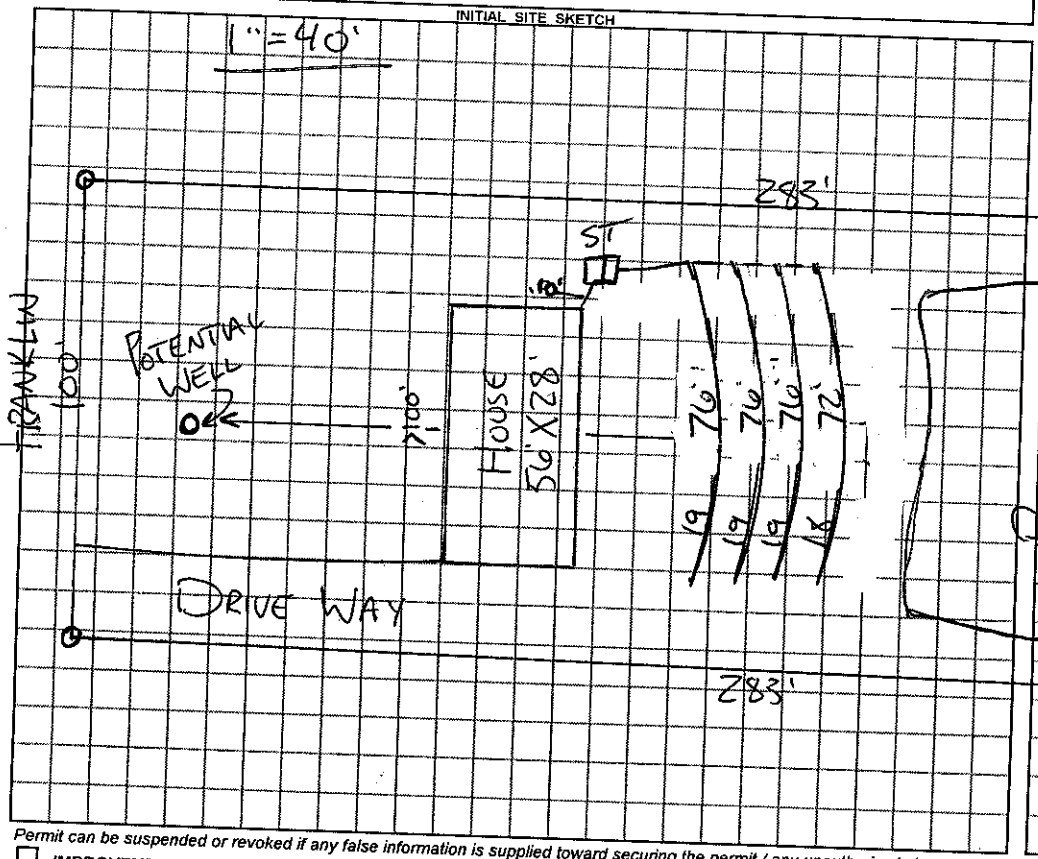

AS BUILT SKETCH

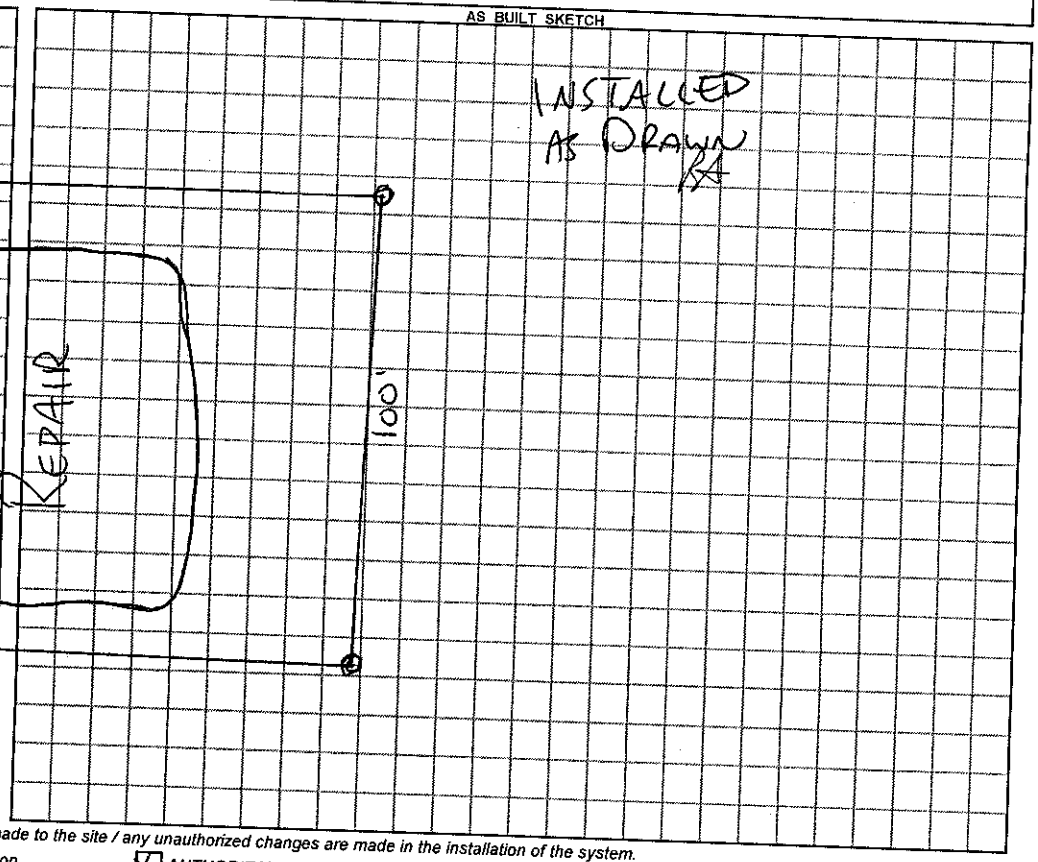

Permit can be suspended or revoked if any false information is supplied toward securing the permit / any unauthorized changes are made to the site / any unauthorized changes are made in the installation of the system.

☐ ***IMPROVEMENT PERMIT*** with plat valid without expiration. ☐ ***IMPROVEMENT PERMIT*** with plat valid without expiration. ☒ ***AUTHORIZATION TO CONSTRUCT*** valid for period equal to IMPROVEMENT PERMIT--not to exceed 60 mo.

Owner / Applicant Signature: Eric Ward Date 6-15-12 Installed by: A-1

IMPROVEMENT PERMIT by: REHS Date 6-13-12 OPERATION PERMIT by: REHS Date 7-11-12

AUTHORIZATION TO CONSTRUCT by: REHS Date 6-13-12 Existing System Inspected by: REHS Date

YOU SHOULD CONTACT A LOCATOR SERVICE PRIOR TO ANY EXCAVATION

White Copy – Environmental Health YELLOW COPY (Final) Owner / Applicant PINK COPY (Initial) Owner / Applicant