4666 66 1022

IREDELL COUNTY HEALTH DEPARTMENT - *ENVIRONMENTAL HEALTH* ☐ STATESVILLE OFFICE 704-878-5305 ☐ MOORESVILLE OFFICE 704-664-5281

IMPROVEMENT PERMIT / AUTHORIZATION TO CONSTRUCT / OPERATION PERMIT / EXISTING SYSTEM INSPECTION

PERMIT# Repair PIN # 4666 66 0061 DATE 6-7-2012

OWNER Dafna & Harry Sprouse APPLICANT: Same PHONE: Home/Cell # Dafna 704 577-6698 Business # 704 664 4405

SITE ADDRESS 145 Franklin Dr. M'ville OWNER / APPLICANT ADDRESS Same

SITE DIRECTIONS Hwy 3 S towards Kannapolis ~ 1 mile out of Downtown TR Franklin Dr. near end

SUBDIVISION Four Oaks BL 3 BLOCK / SECTION LOT # 13 LOT AREA 2.73 Ac DESIGN FLOW 360gpd L.T.A.R. .25-.3

EX ST

Septic Tank 1000 Gallons: STB Date

Pump Tank Gallons: P T Date

Pump Make Model Serial #

No. Nitrification Fields: 1 No. Lines 4 Linear Feet 300'

Trench Width 36" Max. Trench Bottom Depth 36" Gravel Depth N/A

☐ New System ☒ Repair ☐ Expansion System Type I II III IV V VI

System Description: Gravity - Conventional

Repair System Description: Gravity - 25% Reduction

Maintenance Agreement Required ☐ YES ☒ NO

☒ GRAVITY ☐ PRESSURE

☒ Residence No. Bedrooms 3

☐ Business No. Persons

☐ Other No. Employees

☐ Slab ☐ Crawl Space

☒ Basement w/plumbing ☐ Basement w/o plumbing


Water Supply: ☒ Private ☐ Public ☐ Community

Comments / Conditions:


1) IF existing ST is found to be structurally sound then okay to reuse. If not new 1000gal ST need.

Install new drainlines as shown (on Contour) stay at least 10ft from existing Drainfield. Solid pipe under pool drain or atleast 5ft setback.

INITIAL SITE SKETCH

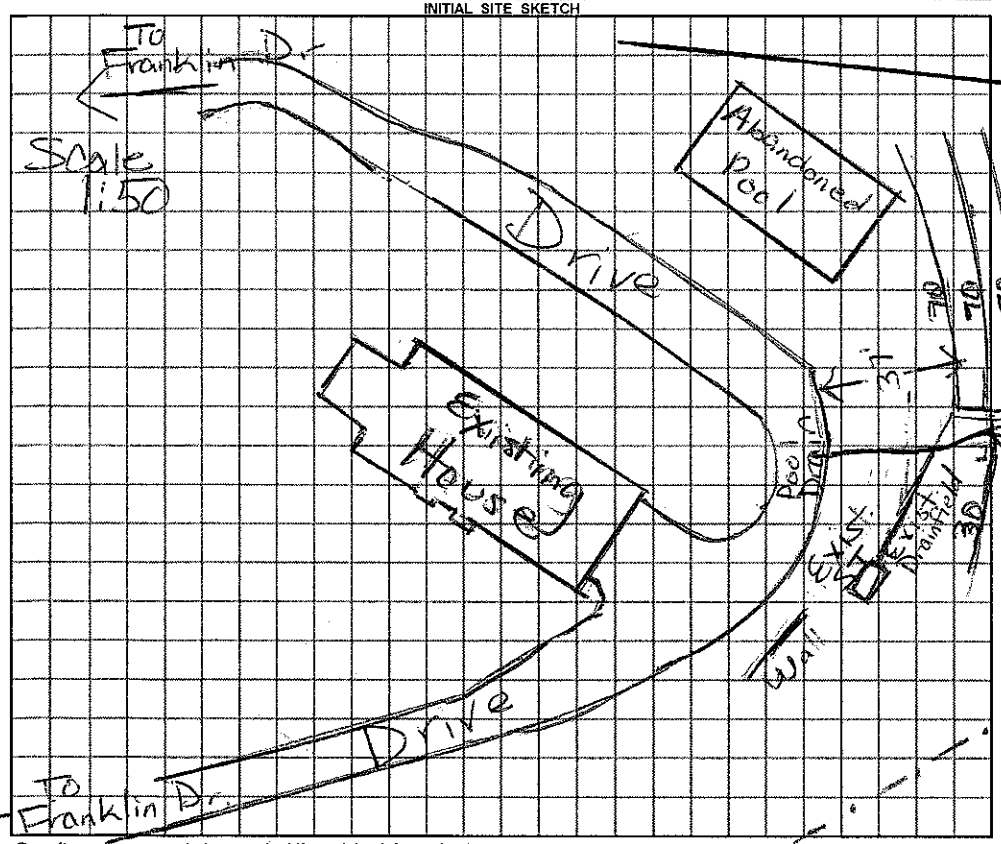

AS BUILT SKETCH

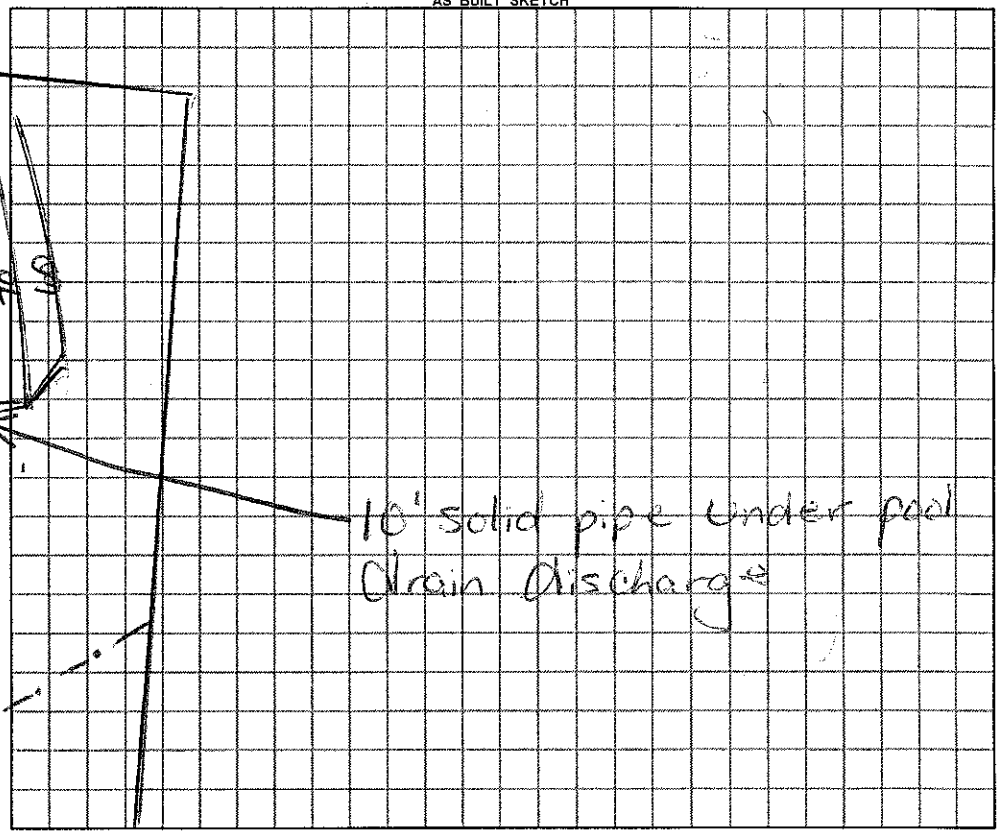

Permit can be suspended or revoked if any false information is supplied toward securing the permit / any unauthorized changes are made to the site / any unauthorized changes are made in the installation of the system.

☐ ***IMPROVEMENT PERMIT*** with plat valid without expiration. ☐ ***IMPROVEMENT PERMIT*** with plat ~~valid without expiration~~ site plan valid 60 mo. ☐ ***AUTHORIZATION TO CONSTRUCT*** valid for period equal to IMPROVEMENT PERMIT--not to exceed 60 mo.

Owner / Applicant Signature: X Harry Sprouse Date

Installed by: Russell Williams

Repair IMPROVEMENT PERMIT by: Maiwand Olson REHS Date 6/7/12

Repair AUTHORIZATION TO CONSTRUCT by: Maiwand Olson REHS Date 6/7/12

OPERATION PERMIT by: REHS Date

Existing System Inspection: Maiwand Olson REHS Date 6/26/12

YOU SHOULD CONTACT A LOCATOR SERVICE PRIOR TO ANY EXCAVATION

White Copy – Environmental Health YELLOW COPY (Final) Owner / Applicant PINK COPY (Initial) Owner / Applicant