IREDELL COUNTY HEALTH DEPARTMENT

STATESVILLE 704-878-5305 MOORESVILLE 704-664-5281

IMPROVEMENT PERMIT / CERTIFICATE OF COMPLETION / OPERATION PERMIT / EXISTING SYSTEM INSPECTION

PROPERTY DESCRIPTION NO. 3046 DATE 12/1/94 TAX MAP NO. 145-B 2+3 Watershed: ☐ Yes ☑ No

OWNER OR CONTRACTOR Bradley Leonard PHONE: Business Home 663-2588

ADDRESS 114 Franklin Dr. Mooresville, NC. 28115 PIN# 4666-66-7235

LOCATION 136 S. TR on Franklin Dr. to 2nd house on (R)

SUBDIVISION Four Oaks BLOCK / SECTION LOT 2+3 LOT AREA ~23,520 SITE CLASS. P DESIGN FLOW L.T.A.R.

Septic Tank: 1000 Gallons; STB 794 Date 1-25-96
Pump Tank: Gallons; PT Date
Pump Make: Model Serial No.
Nitrification Field: No Fields 1 Square Feet 1200 Linear Feet 400
No Lines 5 Trench Width 36" Max Trench Bottom Depth 30" Gravel Depth 12"

☑ New System ☐ Repair System Type: I, II, III, IV, V, VI
System Description: CONV - Drop Boxes
Repair System Description:
Maintenance Agreement Required: ☐ Yes ☑ No


☑ House/Mod. Home No. Bedrooms 3
☐ Mobile Home No. Bathrooms 2
☐ Business No. Employees
☐ Other
☐ Slab ☑ Crawl Space ☐ Basement w/plumbing ☐ Basement wo/plumbing

Water Supply: ☑ Individual ☐ Community ☐ Public

Comments:

Comments: 3 lines checked 5/14/96
All line checked

INITIAL SITE SKETCH

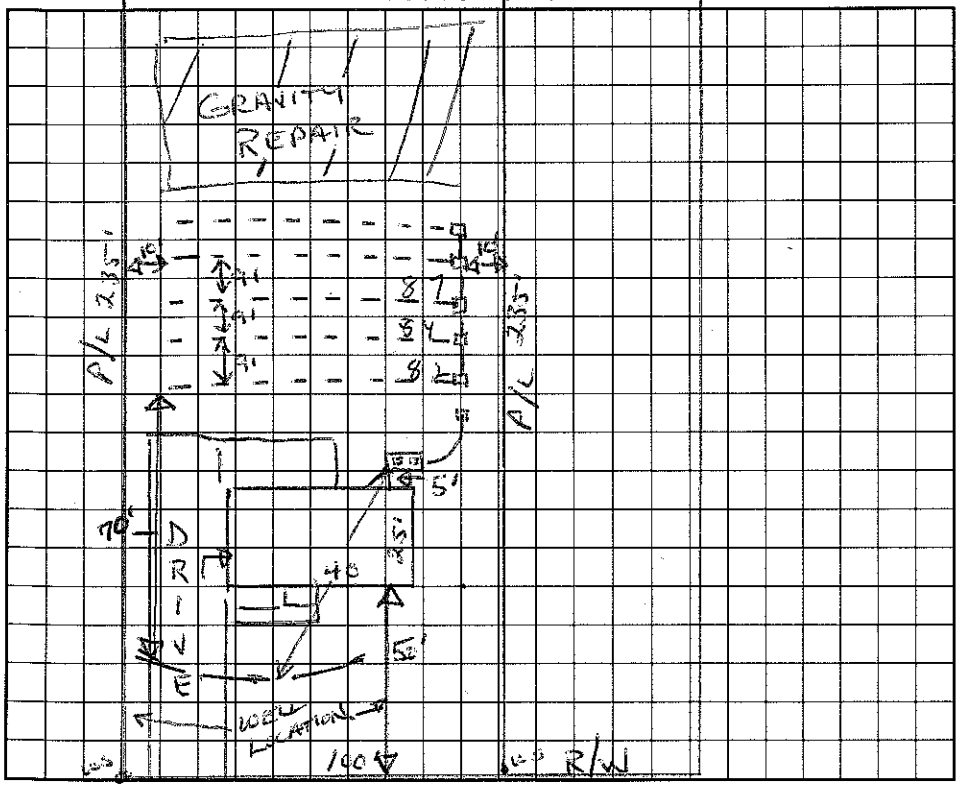

AS BUILT SKETCH

Same as Initial site sketch

I understand that this permit can be suspended or revoked if any false information is supplied toward securing the permit/any unauthorized changes are made to the site/any unauthorized changes are made in the installation of the system. Improvement Permit is valid for 60 months from date of issuance.

Signed: — Left in vehicle per request —

Improvement Permit by: Wesley Sparks RS date 12/1/94

Existing System Inspection by: date

Installed by: Tim Ammons

Certificate of Completion by: date

Operation Permit by: C. Bud Teem EHSI date 5/15/96

HEALTH DEPT. COPY: WHITE INSPECTION COPY (FINAL): GREEN OWNER COPY (FINAL): YELLOW INSPECTION COPY (INITIAL): PINK OWNER COPY (INITIAL): GOLD