IREDELL COUNTY HEALTH DEPARTMENT

STATESVILLE 704-878-5305 MOORESVILLE 704-664-5281

IMPROVEMENT PERMIT / AUTHORIZATION TO CONSTRUCT / OPERATION PERMIT / EXISTING SYSTEM INSPECTION

PERMIT# 4407 PIN# ~~4458 26, 27~~ 4666-66-8582 DATE 3/16/98

OWNER OR CONTRACTOR BILL HUNTER PHONE: Business _____ Home _____

ADDRESS 646 HEATHERLY DR MOORESVILLE NC 28115

LOCATION 136 S - TR FOUR OAKS - ON LEFT

SUBDIVISION FOUROAKS BLOCK / SECTION _____ LOT 26 & 27 LOT AREA ~.5AC SITE CLASS. PS DESIGN FLOW 360 GPD L.T.A.R. .36PD/AC

Septic Tank: 1000 Gallons; STB 1612 Date 9/2/98
Pump Tank: _____ Gallons; PT _____ Date _____
Pump Make: _____ Model _____ Serial No. _____
Nitrification Field: No Fields 1 Square Feet 900 Linear Feet 300
No Lines 5@60' Trench Width 36" Max Trench Bottom Depth 36" Gravel Depth NA

☑ New System ☐ Repair System Type: I, II, (III), IV, V, VI
System Description: GRAVITY CHAMBERED DRAIN
Repair System Description: PANEL
Maintenance Agreement Required: ☐ Yes ☑ No

☑ House/Mod. Home No. Bedrooms 3
☐ Mobile Home No. Bathrooms 2
☐ Business No. Employees _____
☐ Other _____


☐ Slab ☐ Crawl Space ☑ Basement w/plumbing ☐ Basement wo/plumbing

Water Supply: ☑ Individual ☐ Public ☐ Community

Comments:/Conditions:

Comments:/Conditions:

INITIAL SITE SKETCH 1"=50'

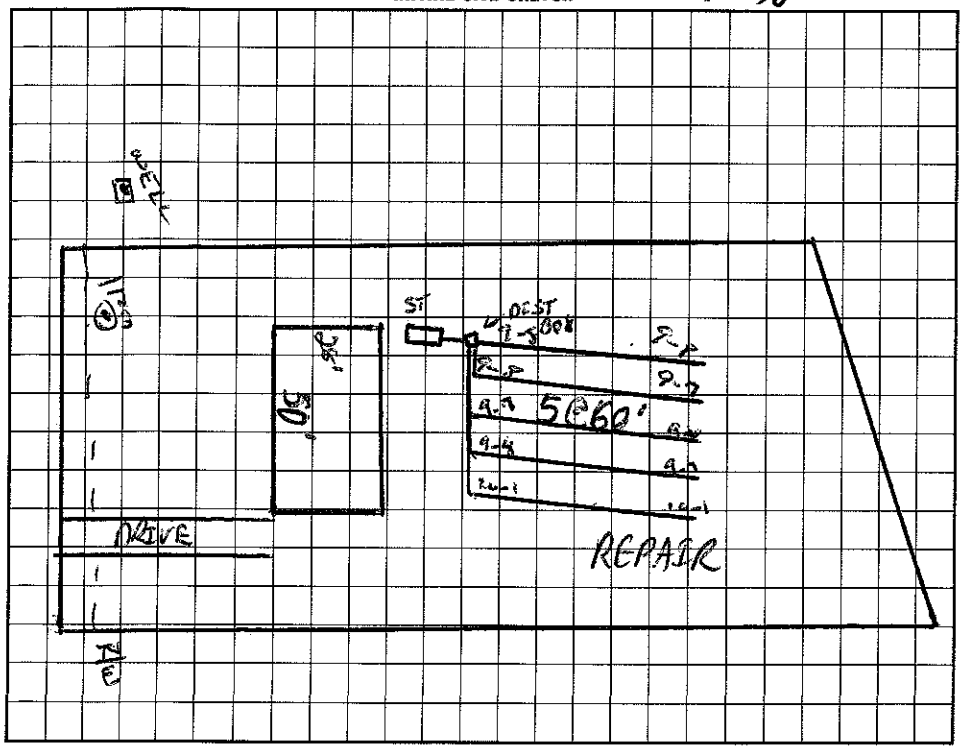

AS BUILT SKETCH

I understand that this permit can be suspended or revoked if any false information is supplied toward securing the permit/any unauthorized changes are made to the site/any unauthorized changes are made in the installation of the system. Improvement Permit with plat valid without expiration. Improvement Permit with site plan valid for sixty months. Authorization to Construct is valid for a period equal to that of Improvement Permit – not to exceed sixty months.

Signed: _____ date 3/16/98 Installed by: Forest Shuford

Improvement Permit by: C. _____ RS date 3/16/98 Operation Permit by: Wesley Sparks RS. date 12/4/98

Authorization to Construct by: C. _____ RS date 3/16/98 Existing System Inspection by: _____ date _____

HEALTH DEPT. COPY: WHITE INSPECTION COPY (FINAL): GREEN OWNER COPY (FINAL): YELLOW INSPECTION COPY (INITIAL): PINK OWNER COPY (INITIAL): GOLD