2:30

IREDELL COUNTY HEALTH DEPARTMENT

AUTHORIZATION TO CONSTRUCT

STATESVILLE 704-878-5305 MOORESVILLE 704-664-5281

IMPROVEMENT PERMIT / ~~CERTIFICATE OF COMPLETION~~ / OPERATION PERMIT / EXISTING SYSTEM INSPECTION

PROPERTY DESCRIPTION NO. 4406 DATE 4/28/97 TAX MAP NO. 1H 5B 25, 29 Watershed: ☐ Yes ☒ ~~No~~

OWNER OR CONTRACTOR WILLIAM HUNTER PHONE Business _____ Home _____

ADDRESS 626 HEATHERLY RD MOORESVILLE PIN# 4666-60-0428

LOCATION 136S - TR FOUR OAKS - FIRST ON LT

SUBDIVISION FOUR OAKS BLOCK / SECTION _____ LOT 28 & 29 LOT AREA ~1.5 AC SITE CLASS. PS DESIGN FLOW 300 GPD L.T.A.R. .3 gpd/FA

Septic Tank: 1000 Gallons; STB 327 Date 11/27/97

Pump Tank: _____ Gallons; PT _____ Date _____

Pump Make: _____ Model _____ Serial No. _____

Nitrification Field: No Fields 1 Square Feet 900 Linear Feet 300

No Lines 4@75 Trench Width 36" Max Trench Bottom Depth 36" Gravel Depth NA

☒ New System ☐ Repair System Type: I, II, III, IV, V, VI

System Description: GRAVITY CHAMBERED

Repair System Description: PANEL

Maintenance Agreement Required: ☐ Yes ☒ No

☒ House/Mod. Home No. Bedrooms 3

☐ Mobile Home No. Bathrooms 2

☐ Business No. Employees ____

☐ Other _____


☐ Slab ☒ Crawl Space ☐ Basement w/plumbing ☐ Basement wo/plumbing

Water Supply:
☒ ~~Individual~~
☐ Community
☐ Public

Comments:

Comments: LOWER LINE CHECKED

INITIAL SITE SKETCH

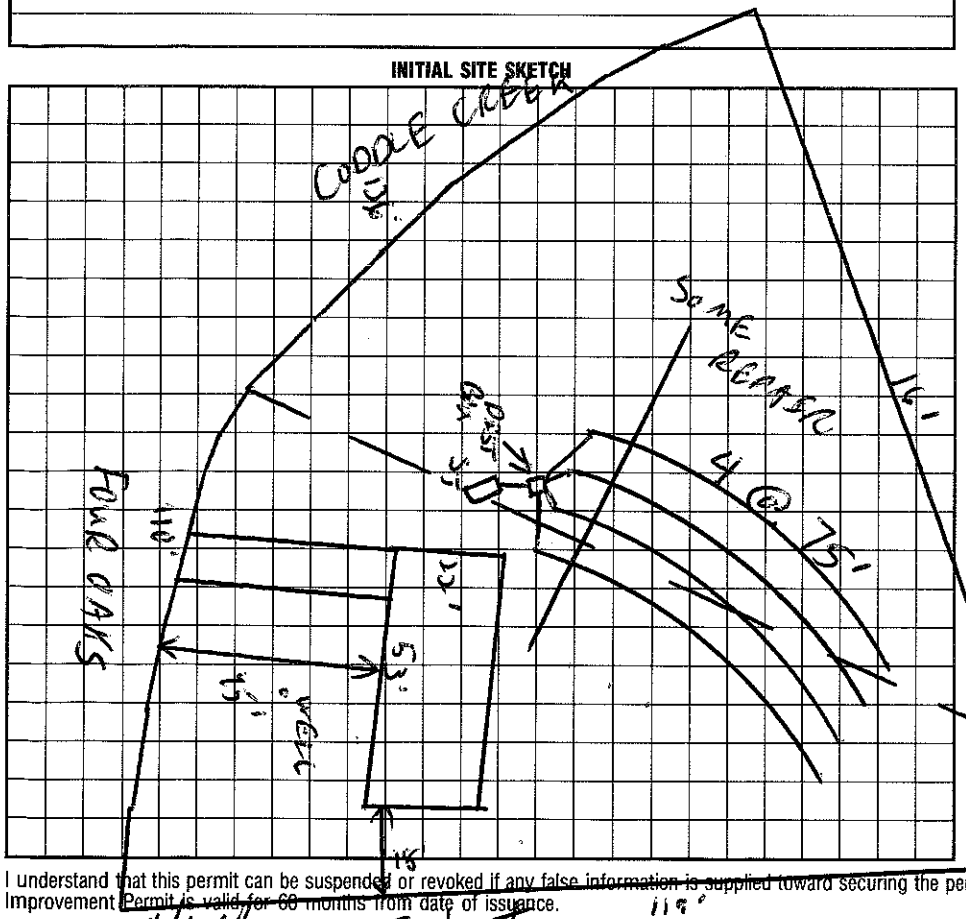

AS BUILT SKETCH

I understand that this permit can be suspended or revoked if any false information is supplied toward securing the permit/any unauthorized changes are made to the site/any unauthorized changes are made in the installation of the system. ~~Improvement Permit is valid for 60 months from date of issuance.~~

Signed: William F Hunter

Installed by: PIEDMONT SEPTIC

Improvement Permit by: _____ date 4/28/97

AUTHORIZATION TO CONSTRUCT

Existing System Inspection by: _____ date 4/25/97

Certificate of Completion by: _____ date _____

Operation Permit by: _____ date 12/1/98

HEALTH DEPT. COPY: WHITE INSPECTION COPY (FINAL): GREEN OWNER COPY (FINAL): YELLOW INSPECTION COPY (INITIAL): PINK OWNER COPY (INITIAL): GOLD