MW

ICHD - ENVIRONMENTAL HEALTH DIVISION

Statesville Office (704) 878-5305 | Mooresville Office (704) 660-3625 | PERMIT # 2023-19894

SEPTIC: IMPROVEMENT PERMIT / AUTHORIZATION TO CONSTRUCT / OPERATION PERMIT / EXISTING SYSTEM

PIN # 4660 -- 67 -- 8511 ✓





SUBDIVISION: – | SECTION: – | LOT # – | LOT AREA: 1.86 acres | DESIGN FLOW: EX | L.T.A.R.: EX


Septic Tank 1000 (gal)	STB Infiltrator	Date	☐ New System ☒ Repair ☐ Expansion	System Type: I (II) III IV V VI	☒ Residence	No. Bedrooms EX	Water Supply
Pump Tank (gal)	PT	Date	System Description: Tank Replacement		☐ Business	No. Persons EX	☒ Private
Pump Make	Model	Serial #	Repair System Description:		☐ Other	No. Employees	☐ Public
# Nitrification Fields EX	# Lines EX	Linear Ft EX	Maintenance Agreement Required:	☐ YES ☒ NO	☐ Slab	☒ Crawl Space	☐ Community
Trench Width EX	Trench Bottom Depth(Low side) EX	Gravel Depth EX	☒ GRAVITY	☐ PRESSURE	☐ Basement w/plumbing	☐ Basement w/o plumbing	

Comments / Conditions: Pump, crush, & fill old septic tank Replace distribution if necessary

INITIAL SITE SKETCH

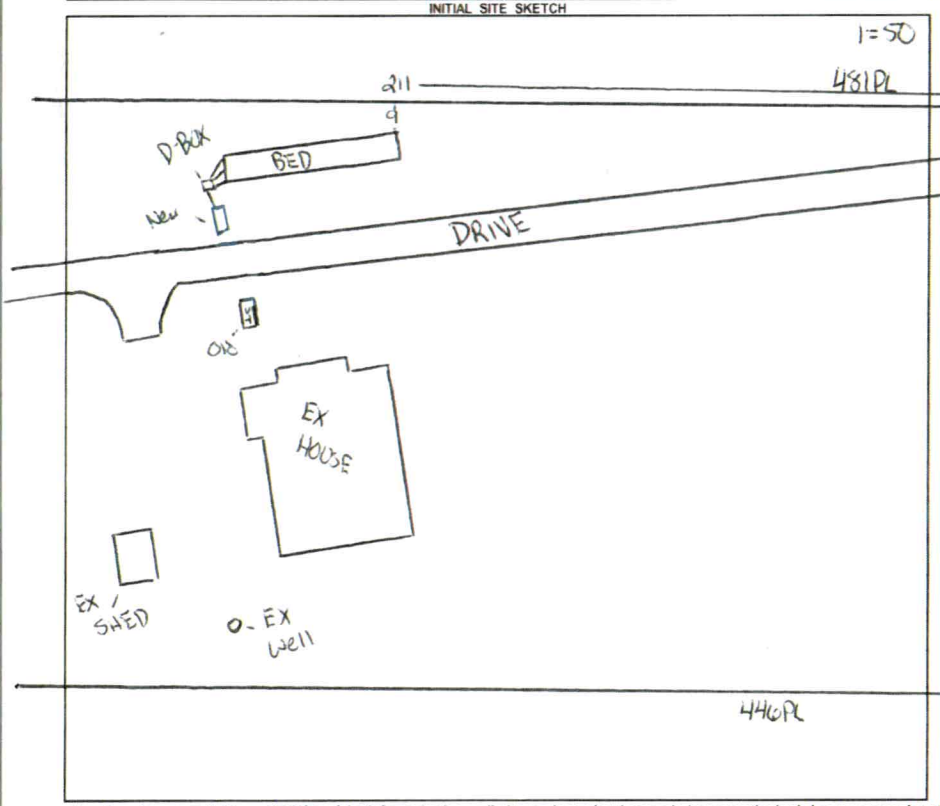

AS BUILT SKETCH

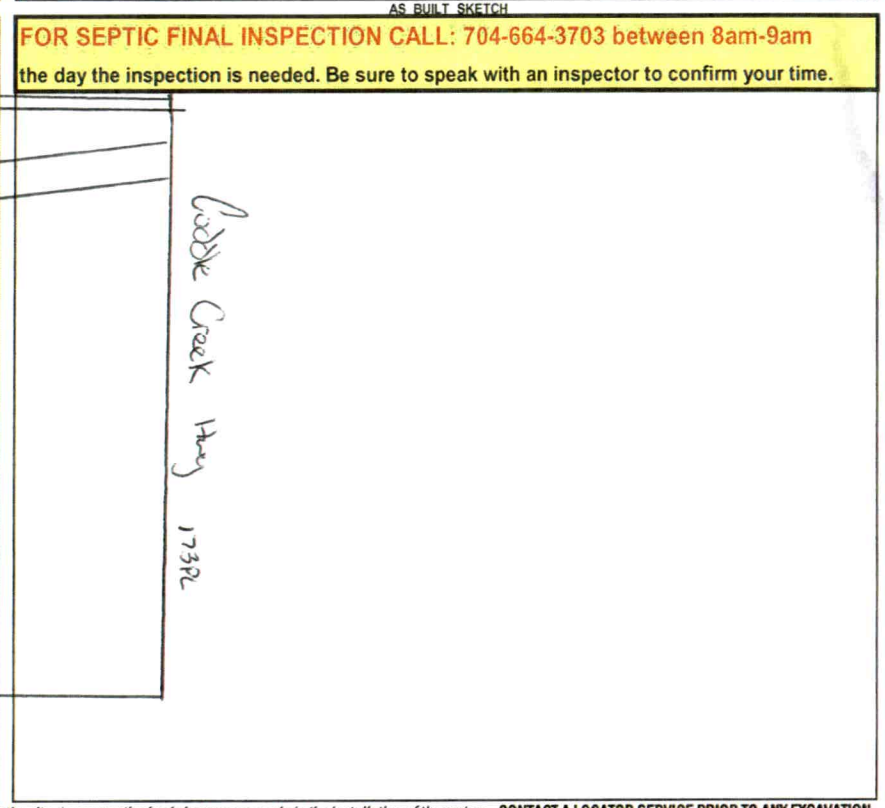

FOR SEPTIC FINAL INSPECTION CALL: 704-664-3703 between 8am-9am the day the inspection is needed. Be sure to speak with an inspector to confirm your time.

Permit can be suspended or revoked if any false information is supplied toward securing the permit / any unauthorized changes are made to the site / any unauthorized changes are made in the installation of the system. **CONTACT A LOCATOR SERVICE PRIOR TO ANY EXCAVATION**

☐ **IMPROVEMENT PERMIT** ***with plat*** *valid without expiration.* ☒ **IMPROVEMENT PERMIT** ***with site plan*** *valid for 60 mos.* ☒ **AUTHORIZATION TO CONSTRUCT** *valid for period equal to IMPROVEMENT PERMIT--not to exceed 60 mo.*

Owner / Applicant Signature: Online Signature | Date: | Installed by: B.O.S.S

IMPROVEMENT PERMIT by: Cory Whit | Date: 4/4/23 | OPERATION PERMIT by: Matt Wi | Date: 4/27/23

AUTHORIZATION TO CONSTRUCT by: Cory Whit | Date: 4/4/23 | Existing System Inspected by: | Date:

FOR SEPTIC FINAL INSPECTION: CALL 704-664-3703 between 8am-9am the day the inspection is needed.

MW

ICHD - ENVIRONMENTAL HEALTH DIVISION

Statesville Office (704) 878-5305 | Mooresville Office (704) 660-3625

PERMIT # 2023-19894

SEPTIC: IMPROVEMENT PERMIT / AUTHORIZATION TO CONSTRUCT / OPERATION PERMIT / EXISTING SYSTEM

PIN # 4660 -- 67 -- 8511

APPLICANT/OWNER: Claire Tomkinson | APPLICANT ADDRESS: 1108 Caddle Creek Hwy, Mooresville

SITE ADDRESS: 1108 Caddle Creek Hwy, Mooresville 28115 | PHONE: 704-975-5981 | ALT. PHONE –

SITE DIRECTIONS: E Center Ave - Caddle Creek | SAP CONTROLLED: ☐ YES ☐ NO


SUBDIVISION: – | SECTION: – | LOT # – | LOT AREA: 1.86 acres | DESIGN FLOW: EX | L.T.A.R.: EX

Septic Tank	1000 (gal)	STB	Date	☐ New System	☒ Repair	☐ Expansion	System Type: I (II) III IV V VI	☒ Residence	No. Bedrooms EX
Pump Tank	(gal)	PT	Date	System Description:	Tank Replacement			☐ Business	No. Persons EX
Pump Make	Model		Serial #	Repair System Description:				☐ Other	No. Employees
# Nitrification Fields	EX # Lines EX		Linear Ft EX	Maintenance Agreement Required:		☐ YES	☒ NO	☐ Slab	☒ Crawl Space
Trench Width	EX Trench Bottom Depth(Low side) EX		Gravel Depth EX			☒ GRAVITY	☐ PRESSURE	☐ Basement w/plumbing	☐ Basement w/o plumbing


Water Supply: ☒ Private ☐ Public ☐ Community

Comments / Conditions: Pump, crush, & fill old septic tank. Replace distribution if necessary.

INITIAL SITE SKETCH

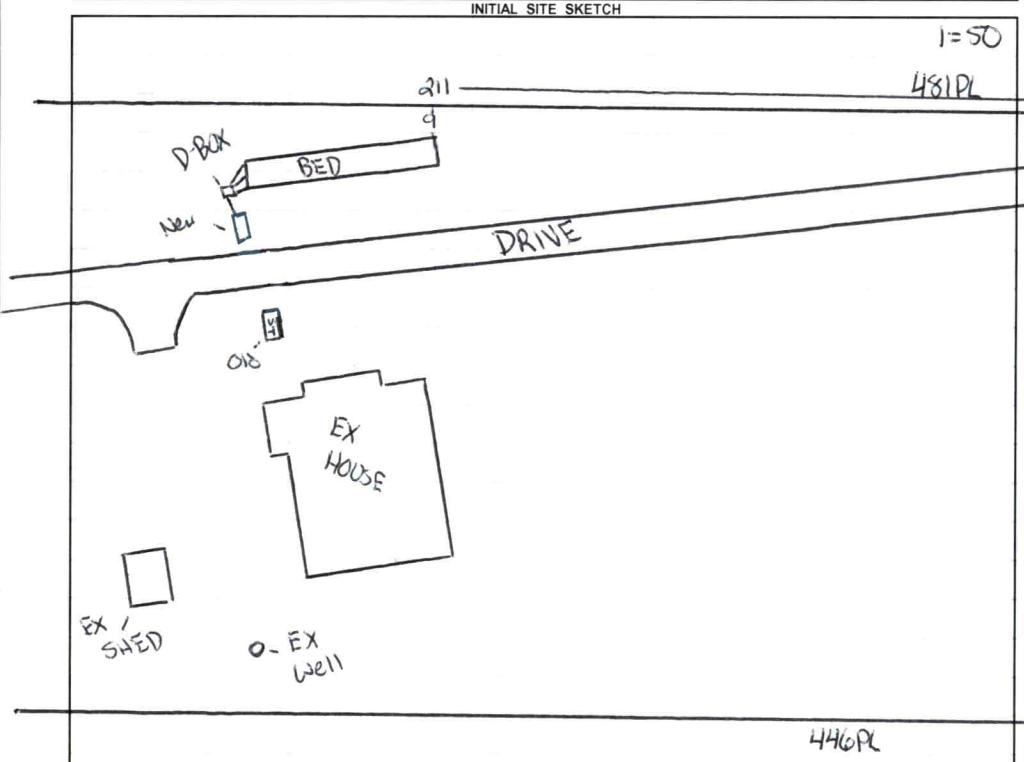

AS BUILT SKETCH

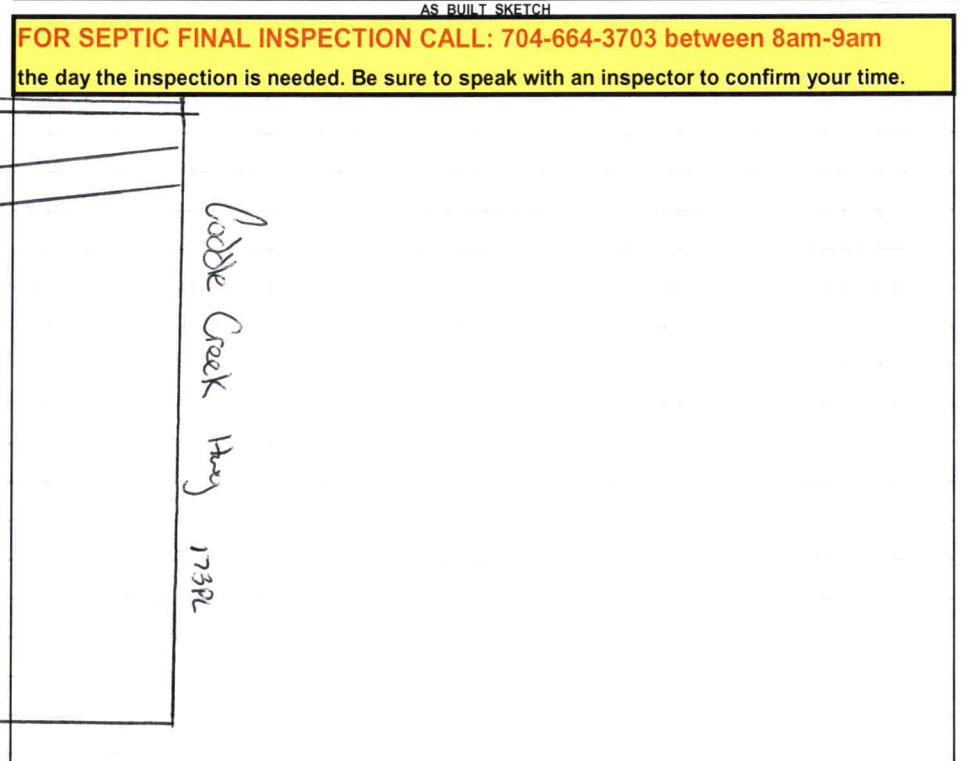

FOR SEPTIC FINAL INSPECTION CALL: 704-664-3703 between 8am-9am
the day the inspection is needed. Be sure to speak with an inspector to confirm your time.

Permit can be suspended or revoked if any false information is supplied toward securing the permit / any unauthorized changes are made to the site / any unauthorized changes are made in the installation of the system. **CONTACT A LOCATOR SERVICE PRIOR TO ANY EXCAVATION**


☐ **IMPROVEMENT PERMIT** ***with plat*** *valid without expiration.* ☒ **IMPROVEMENT PERMIT** ***with site plan*** *valid for 60 mos.* ☒ **AUTHORIZATION TO CONSTRUCT** *valid for period equal to IMPROVEMENT PERMIT--not to exceed 60 mo.*

Owner / Applicant Signature: Online Signature | Date: | Installed by:

IMPROVEMENT PERMIT by: Cory Whit | Date: 4/4/23 | OPERATION PERMIT by: | Date:

AUTHORIZATION TO CONSTRUCT by: Cory Whit | Date: 4/4/23 | Existing System Inspected by: | Date:

FOR SEPTIC FINAL INSPECTION: CALL 704-664-3703 between 8am-9am the day the inspection is needed.

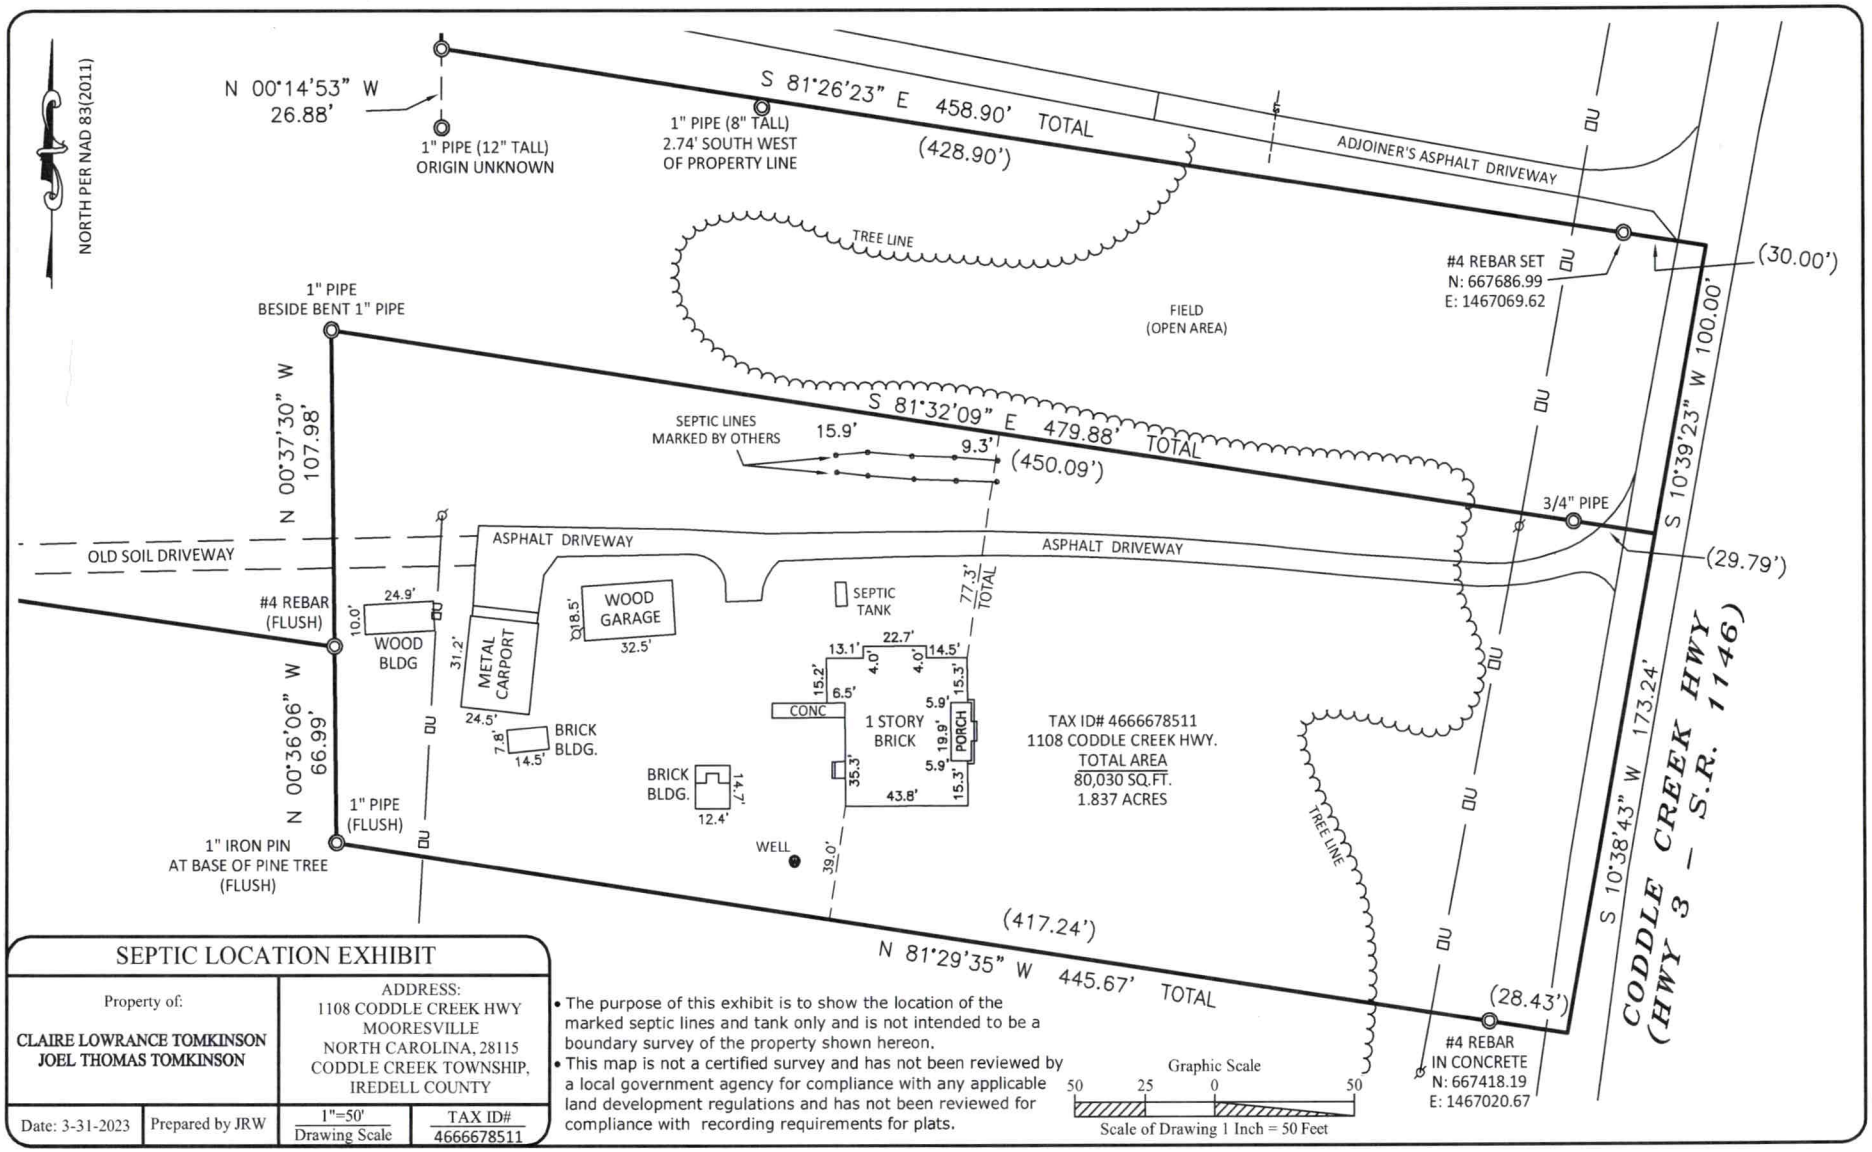

SEPTIC LOCATION EXHIBIT

Property of:	ADDRESS:
CLAIRE LOWRANCE TOMKINSON JOEL THOMAS TOMKINSON	1108 CODDLE CREEK HWY MOORESVILLE NORTH CAROLINA, 28115 CODDLE CREEK TOWNSHIP, IREDELL COUNTY

Date: 3-31-2023	Prepared by JRW	1"=50' Drawing Scale	TAX ID# 4666678511

- The purpose of this exhibit is to show the location of the marked septic lines and tank only and is not intended to be a boundary survey of the property shown hereon.
- This map is not a certified survey and has not been reviewed by a local government agency for compliance with any applicable land development regulations and has not been reviewed for compliance with recording requirements for plats.