IREDELL COUNTY HEALTH DEPARTMENT

STATESVILLE 704-878-5305 MOORESVILLE 704-664-5281

IMPROVEMENT PERMIT / AUTHORIZATION TO CONSTRUCT / OPERATION PERMIT / EXISTING SYSTEM INSPECTION

PERMIT# 6536 PIN# 4666 70 5269 DATE 4/29/99

OWNER OR CONTRACTOR Nicolas Allen PHONE: Business Home 660-1979

ADDRESS 114 Cristal Nicole Lane Mooresville, NC. 28115

LOCATION Kistler Rd T- Cristal Nicole Lane first lot on (R)

SUBDIVISION Herman Batcher BLOCK / SECTION LOT 1 LOT AREA .83Ac SITE CLASS. PS DESIGN FLOW 360 L.T.A.R. .2

Septic Tank: 1000 Gallons; STB 794 Date 3/19/99
Pump Tank: Gallons; PT Date
Pump Make: Model Serial No.
Nitrification Field: No Fields 1 Square Feet 1800 Linear Feet 600
No Lines 6 Trench Width 36" Max Trench Bottom Depth 30" Gravel Depth 12"

☒ New System ☐ Repair System Type: I, (II), III, IV, V, VI
System Description: Bucs - Conventional
Repair System Description: None
Maintenance Agreement Required: ☐ Yes ☒ No

☒ House/Mod. Home No. Bedrooms 3
☐ Mobile Home No. Bathrooms 2.5
☐ Business No. Employees
☐ Other
☐ Slab ☒ Crawl Space ☐ Basement w/plumbing ☐ Basement wo/plumbing


Water Supply: ☒ Individual ☐ Public ☐ Community

Comments:/Conditions:


Comments:/Conditions:

CRYSTAL NICOLE LANE

INITIAL SITE SKETCH

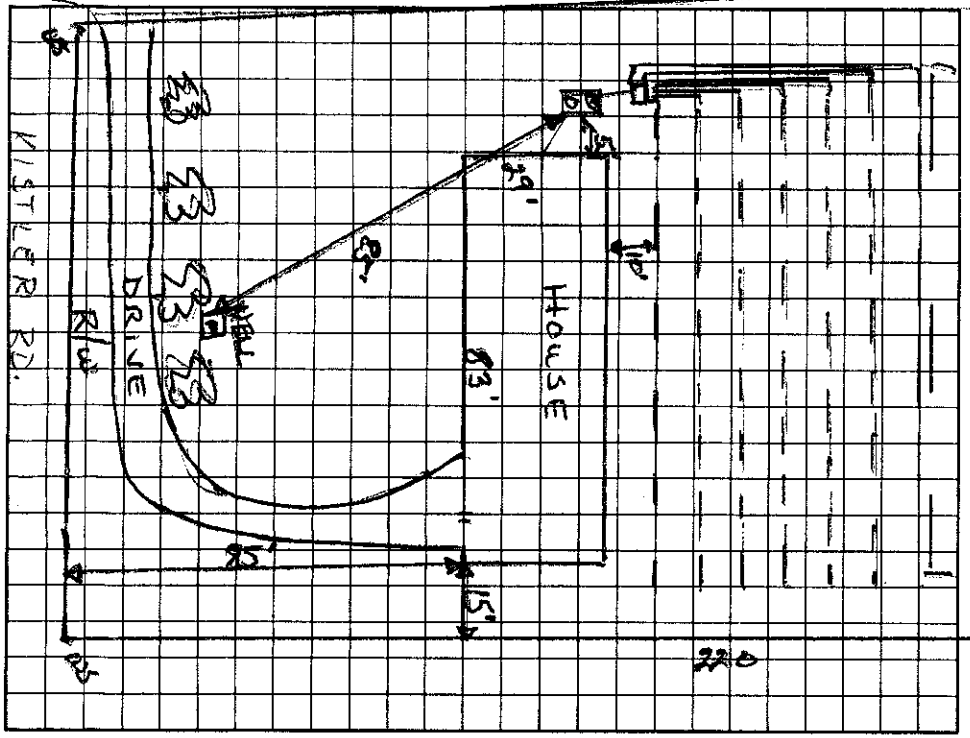

AS BUILT SKETCH

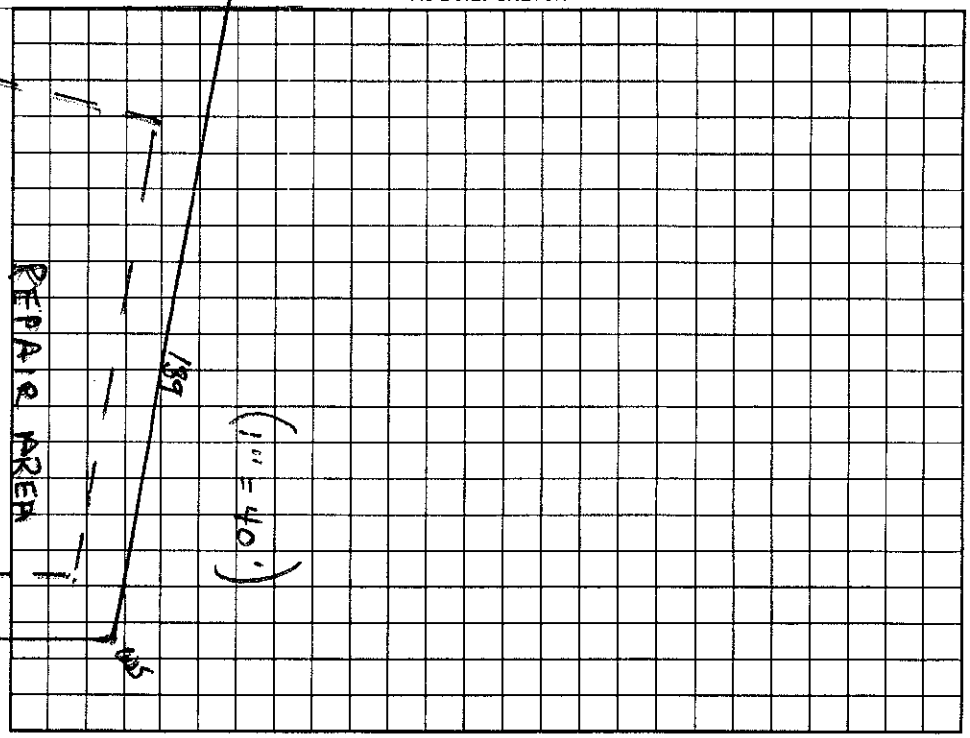

Permit can be suspended or revoked if any false information is supplied toward securing the permit/any unauthorized changes are made to the site/any unauthorized changes are made in the installation of the system. Improvement Permit with plat valid without expiration. Improvement Permit with site plan valid for sixty months. Authorization to Construct is valid for a period equal to that of Improvement Permit – not to exceed sixty months.

Signed: [signature] date 4/30/99

Improvement Permit by: Wesley Sparks R.S. date 4/29/99

Authorization to Construct by: Wesley Sparks R.S. date 4/29/99

Installed by: Nicholas Allen

Operation Permit by: Wesley Sparks R.S. date 10/15/99

Existing System Inspection by: date

HEALTH DEPT. COPY: WHITE OWNER COPY (FINAL): YELLOW OWNER COPY (INITIAL): PINK