IREDELL COUNTY HEALTH DEPARTMENT

STATESVILLE 704-878-5305 MOORESVILLE 704-664-5281

IMPROVEMENT PERMIT / AUTHORIZATION TO CONSTRUCT / OPERATION PERMIT / EXISTING SYSTEM INSPECTION

PERMIT# 5582 PIN# ~~4666721323~~ 4666722180

OWNER OR CONTRACTOR Willie Knox PHONE: Business 663-1704 Home

ADDRESS 188 Kistler Farm Rd Mooresville, NC DATE 7-10-98

LOCATION 1365 TR Kistler Rd

SUBDIVISION BLOCK / SECTION LOT 69 LOT AREA 6 Acre SITE CLASS. DESIGN FLOW L.T.A.R.

Septic Tank: 1000 Gallons; STB Date

Pump Tank: Gallons; PT Date

Pump Make: Model Serial No.

Nitrification Field: No Fields Square Feet Linear Feet

No Lines ~~Trench Width~~ Existing Max Trench Bottom Depth Gravel Depth 12"

☐ New System ☐ Repair System Type: I, II, III, IV, V, VI

System Description: Existing Grav/Conv.

Repair System Description:

Maintenance Agreement Required: ☐ Yes ☐ No

☐ House/Mod. Home ☒ Mobile Home ☐ Business ☐ Other

No. Bedrooms 3 No. Bathrooms 2 No. Employees


☐ Slab ☒ Crawl Space ☐ Basement w/plumbing ☐ Basement wo/plumbing

Water Supply: ☒ Individual ☐ Public ☐ Community

Comments:/Conditions: Existing Septic System appears to be functioning okay No Malfunctions Noticed

Comments:/Conditions: Very deep Drainlines; could touch Septic Tank & beginning of Drainlines; the rest was too deep to touch

INITIAL SITE SKETCH Not to Scale

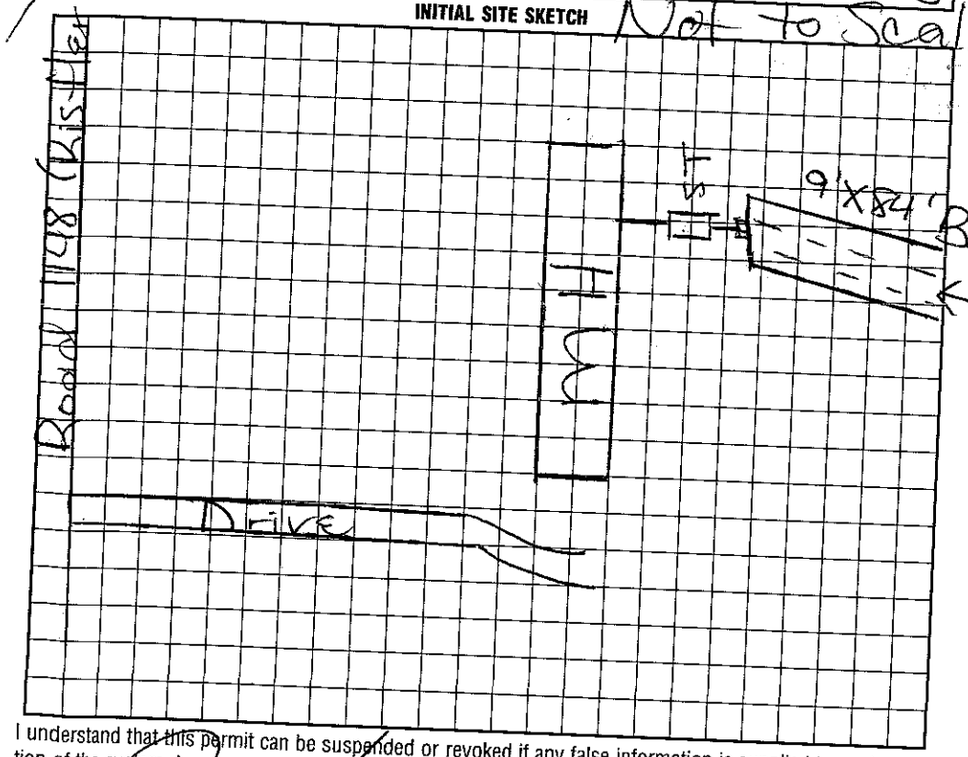

AS BUILT SKETCH

I understand that this permit can be suspended or revoked if any false information is supplied toward securing the permit/any unauthorized changes are made to the site/any unauthorized changes are made in the installation of the system. Improvement Permit with plat valid without expiration. Improvement Permit with site plan valid for sixty months. Authorization to Construct is valid for a period equal to that of Improvement Permit – not to exceed sixty months.

Signed: Agent date

Improvement Permit by: Maria H. Dolgos date 7/10/98

Authorization to Construct by: Maria H. Dolgos date 7/16/98

Existing System

Installed by:

Operation Permit by: date

Existing System Inspection by: date

HEALTH DEPT. COPY (WHITE) INSPECTION COPY (FINAL): GREEN OWNER COPY (FINAL): YELLOW INSPECTION COPY (INITIAL): PINK OWNER COPY (INITIAL): GOLD