93

IREDELL COUNTY HEALTH DEPARTMENT

STATESVILLE 704-878-5305 MOORESVILLE 704-664-5281

IMPROVEMENT PERMIT / AUTHORIZATION TO CONSTRUCT / OPERATION PERMIT / EXISTING SYSTEM INSPECTION

PERMIT# REPAIR PIN# REPAIR 4666760317 DATE 4/6/98

OWNER OR CONTRACTOR VIVIAN SMITH PHONE: Business Home

ADDRESS 1158 COODLE CREEK RD- MOORESVILLE

LOCATION COODLE CREEK RD - # 1158 ON RT

SUBDIVISION — BLOCK / SECTION — LOT — LOT AREA — SITE CLASS. A/S DESIGN FLOW 360 L.T.A.R. —

Septic Tank: 1000 Gallons; STB 1012 Date 2/10/98
Pump Tank: Gallons; PT Date
Pump Make: Model Serial No.
Nitrification Field: No Fields 1 Square Feet 675 Linear Feet 225
No Lines 3 @ 75 Trench Width 36" Max Trench Bottom Depth AS NEEDED Gravel Depth 6"

☒ New System ☒ Repair System Type: ☐ I ☐ II, III, IV, V, VI
System Description: ~~CONVENTIONAL~~
Repair System Description: 6" STONE CONVENTIONAL
Maintenance Agreement Required: ☐ Yes ☒ No


☒ House/Mod. Home No. Bedrooms 3
☐ Mobile Home No. Bathrooms 2
☐ Business No. Employees
☐ Other
☐ Slab ☒ Crawl Space ☐ Basement w/plumbing ☐ Basement wo/plumbing

Water Supply: ☒ Individual ☐ Public ☐ Community

Comments:/Conditions: EXISTING SYSTEM TO BE ABANDONED

Comments:/Conditions:

INITIAL SITE SKETCH NOT TO SCALE

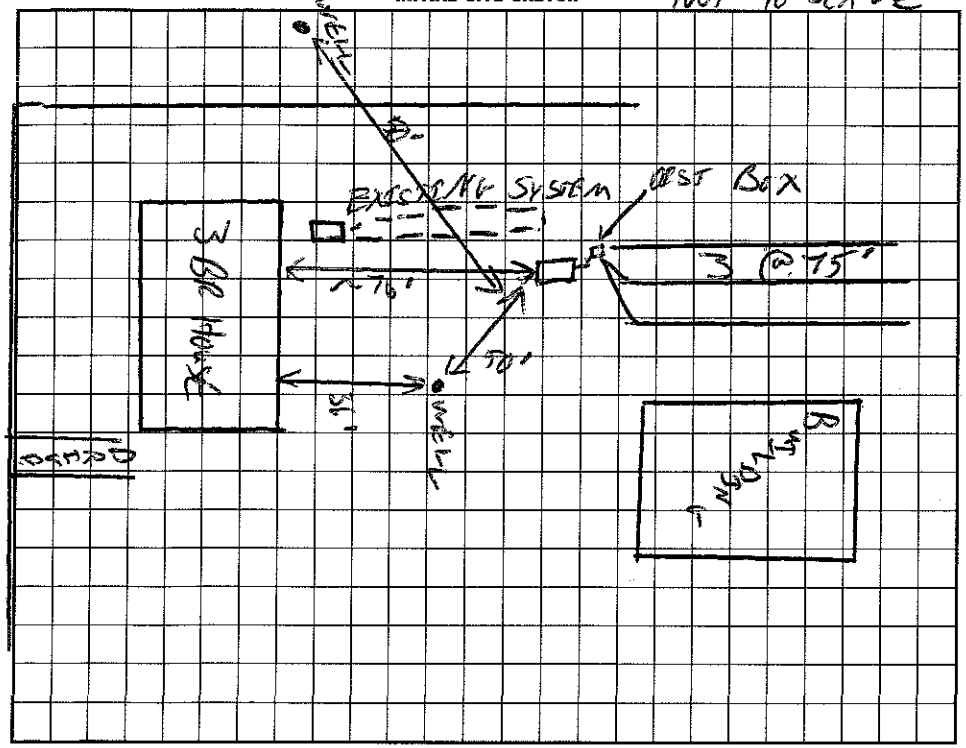

AS BUILT SKETCH

I understand that this permit can be suspended or revoked if any false information is supplied toward securing the permit/any unauthorized changes are made to the site/any unauthorized changes are made in the installation of the system. Improvement Permit with plat valid without expiration. Improvement Permit with site plan valid for sixty months. Authorization to Construct is valid for a period equal to that of Improvement Permit – not to exceed sixty months.

Signed: Vivian L Smith date 4/6/98
Improvement Permit by: C. [illegible] RS date 4/6/98
Authorization to Construct by: C. [illegible] RS date 4/6/98

Installed by: FOREST STAFFORD
Operation Permit by: C. [illegible] date 4/15/98
Existing System Inspection by: C. [illegible] date 4/15/98

HEALTH DEPT. COPY: WHITE INSPECTION COPY (FINAL): GREEN OWNER COPY (FINAL): YELLOW INSPECTION COPY (INITIAL): PINK OWNER COPY (INITIAL): GOLD

