4660800659

IREDELL COUNTY HEALTH DEPARTMENT

STATESVILLE 704-878-5305 MOORESVILLE 704-664-5281

IMPROVEMENT PERMIT / CERTIFICATE OF COMPLETION / OPERATION PERMIT / EXISTING SYSTEM INSPECTION

PROPERTY DESCRIPTION NO. 3739 DATE 3/6/96 TAX MAP NO. 1E - A - 75A Watershed: [ ] Yes [X] No

OWNER OR CONTRACTOR Benny & Dena Brown PHONE: Business _____ Home 663-7955

ADDRESS 269 Kistler Rd. Mooresville, NC. 28115

LOCATION 1365 to Kistler Rd. 0.9 mile on (L), beautifully country

SUBDIVISION No BLOCK / SECTION _____ LOT _____ LOT AREA 1.55AC SITE CLASS. _____ DESIGN FLOW 360 L.T.A.R. _____

Septic Tank: Existing Gallons; STB _____ Date _____

Pump Tank: _____ Gallons; PT _____ Date _____

Pump Make: _____ Model _____ Serial No. _____

Nitrification Field: No Fields ___ Square Feet _____ Linear Feet 400

No Lines _____ Trench Width Existing Max Trench Bottom Depth _____ Gravel Depth _____

[ ] New System [ ] Repair System Type: I, II, III, IV, V, VI

System Description: Existing System

Repair System Description: _____

Maintenance Agreement Required: [ ] Yes [ ] No

[X] House/Mod. Home No. Bedrooms 3

[ ] Mobile Home No. Bathrooms 2

[ ] Business No. Employees ___

[ ] Other _____

[ ] Slab [ ] Crawl Space [ ] Basement w/plumbing [ ] Basement wo/plumbing


Water Supply:
[X] Individual
[ ] Community
[ ] Public

Comments:

Comments:
County book for original 360.

INITIAL SITE SKETCH

AS BUILT SKETCH

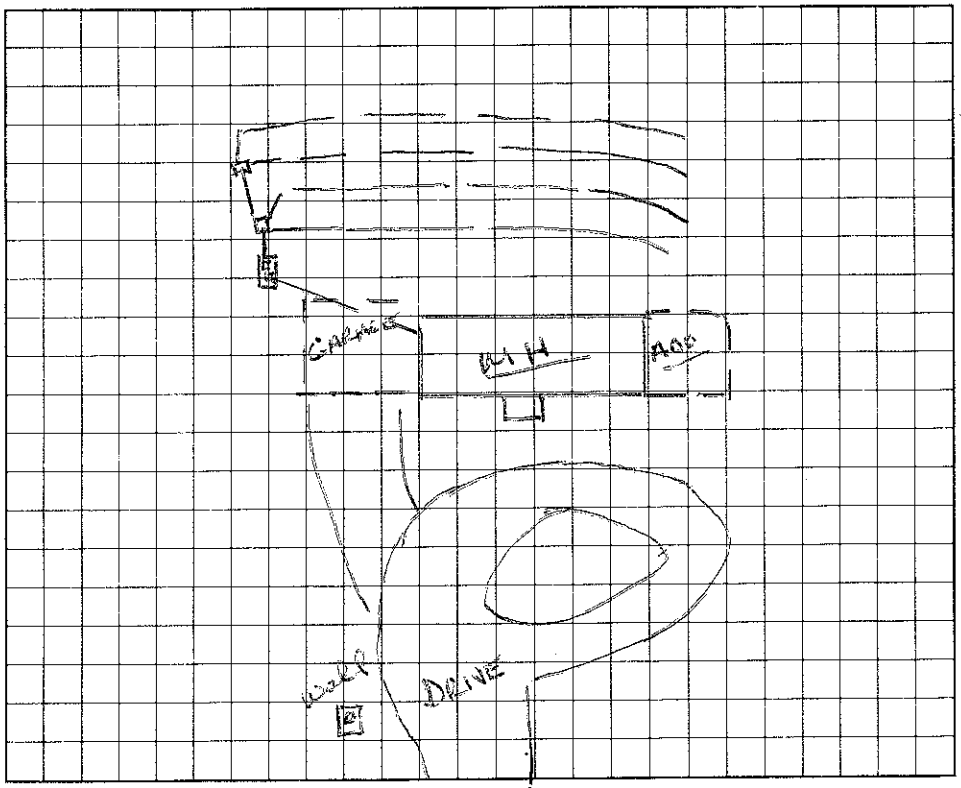

I understand that this permit can be suspended or revoked if any false information is supplied toward securing the permit/any unauthorized changes are made to the site/any unauthorized changes are made in the installation of the system.

Signed: _____

Improvement Permit by: _____ date _____

Existing System Inspection by: _____ date _____

Installed by: Ken Delfinger - 1987

~~Certificate of Completion by:~~ Existing System Wesley Sparks RS. date 3/6/96

Operation Permit by: _____ date _____

HEALTH DEPT. COPY: WHITE INSPECTION COPY (FINAL): GREEN OWNER COPY (FINAL): YELLOW INSPECTION COPY (INITIAL): PINK OWNER COPY (INITIAL): GOLD