IREDELL COUNTY HEALTH DEPARTMENT

STATESVILLE 704-878-5305 MOORESVILLE 704-664-5281

IMPROVEMENT PERMIT / AUTHORIZATION TO CONSTRUCT / OPERATION PERMIT / EXISTING SYSTEM INSPECTION

PERMIT # REPAIR PIN # 4666-92-9063 DATE 12-11-09

OWNER or APPLICANT LAVONNE EKREN PHONE: Business 704-807-7777 Home: HECHT

OWNER or APPLICANT ADDRESS WASHINGTON STATE

LOCATION / DIRECTIONS 1409 CODDLE CREEK HWY

SUBDIVISION — BLOCK / SECTION — LOT # — LOT AREA ~1.4 Ac DESIGN FLOW 360 GPD L.T.A.R. -3

Septic Tank 1000 Gallons: STB 760 Date 8-21-09

Pump Tank — Gallons: P T — Date —

Pump Make — Model — Serial # —

Nitrification Field No Fields 1 No Lines 6 Linear Feet 30X50' BED

Trench Width — Max. Trench Bottom Depth — Gravel Depth TIRECHIPS 12"

☐ New System ☒ Repair ☐ Expansion System Type I (1) II IV V VI

System Description: —

Repair System Description: GRAVITY BED (TIRE CHIPS)

Maintenance Agreement Required ☐ YES ☒ NO

☒ GRAVITY ☐ PRESSURE


☒ Residence No. Bedrooms 2 ☐ Business No. Persons — ☐ Other No. Employees — ☐ Slab ☒ Crawl Space ☐ Basement w/plumbing ☐ Basement w/o plumbing

Water Supply: ☒ Private ☐ Public ☐ Community


Comments / Conditions * MAX DEPTH = 30" *

Comments / Conditions 1) INSTALL 30' X 50' BED 2) TIRE CHIPS CAN BE USED IN PLACE OF GRAVEL 3) PUMP CRUSH & FILL OLD TANK 4) NEW TANK 5' OFF HOUSE 5) BED 10' OFF OF WATER SPIGOT

INITIAL SITE SKETCH

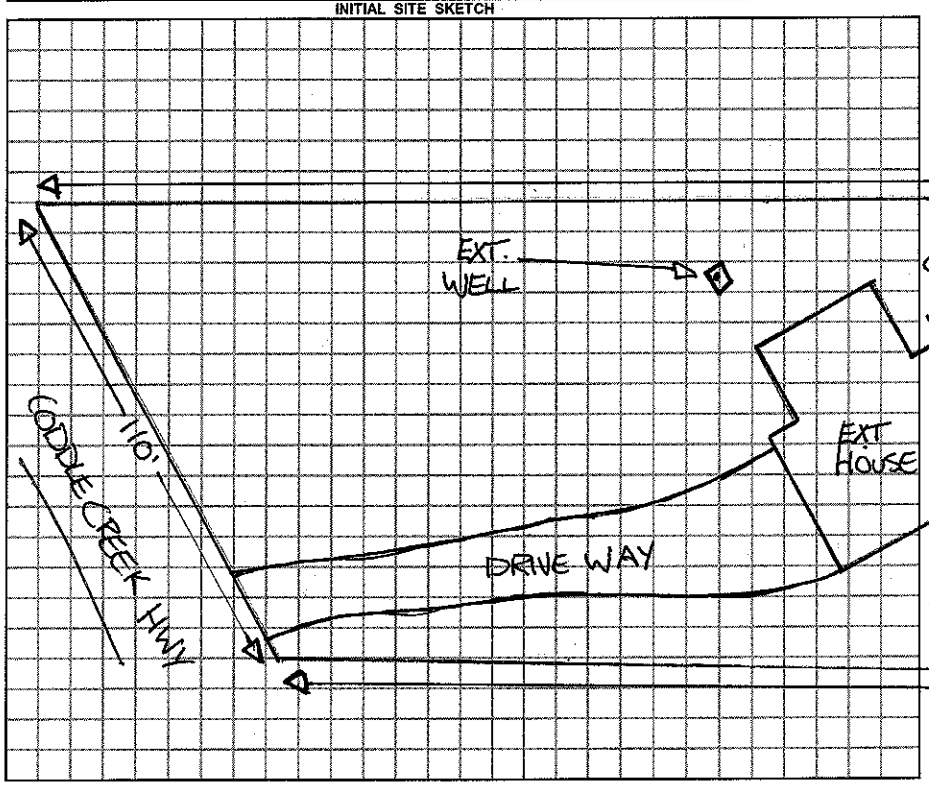

AS BUILT SKETCH

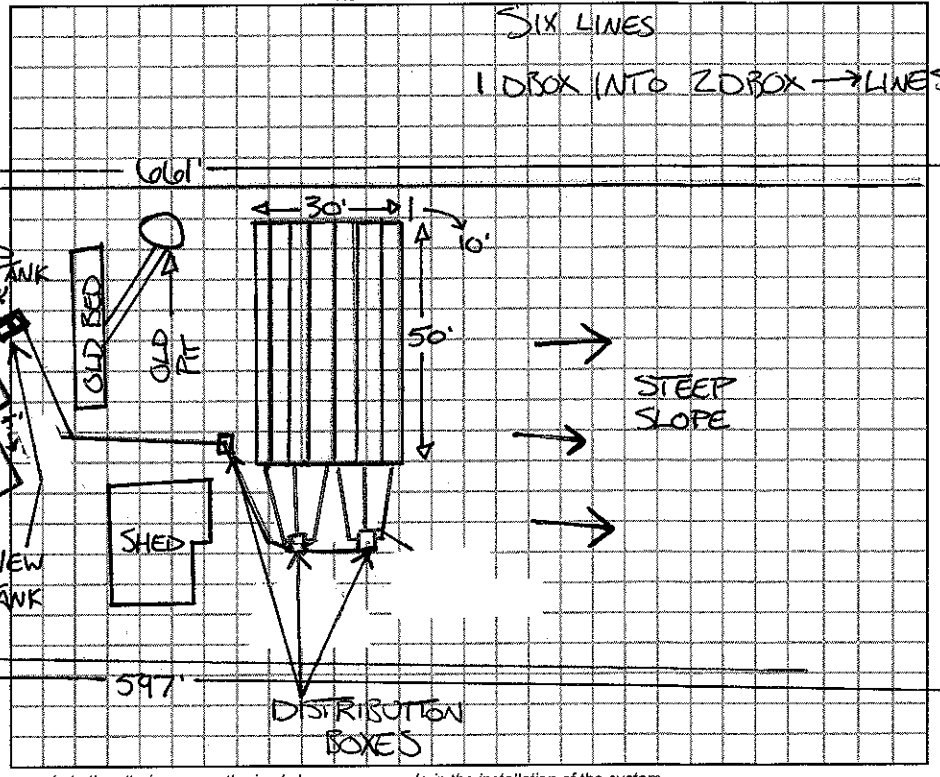

Permit can be suspended or revoked if any false information is supplied toward securing the permit / any unauthorized changes are made to the site / any unauthorized changes are made in the installation of the system.

☐ *IMPROVEMENT PERMIT w / plat valid without expiration.* ☐ *IMPROVEMENT PERMIT w / site plan valid for 60 mos.* ☐ *AUTHORIZATION TO CONSTRUCT valid for period equal to IMPROVEMENT PERMIT-not to exceed 60 mo.*

Owner / Applicant Signature: Jenny Marcia Date 12-14-09

Improvement Permit by: R-A-Lo-E REHS Date 12-11-09

Authorzation to Construct by: R-A-Lo-E REHS Date 12-11-09

YOU SHOULD CONTACT A LOCATOR SERVICE PRIOR TO ANY EXCAVATION.

Installed by: STANLEY SEPTIC

Operation Permit by: R-A-Lo-E REHS Date: 1-5-10

Existing System Inspected by: — Date: —

WHITE COPY Environmental Health YELLOW COPY (Final) Owner / Applicant PINK COPY (Initial) Owner / Applicant