IREDELL COUNTY HEALTH DEPARTMENT

TATESVILLE 704-878-5305
MOORESVILLE 704-664-5281

(300) 4666936828

IMPROVEMENT PERMIT / CERTIFICATE OF COMPLETION / OPERATION PERMIT / EXISTING SYSTEM INSPECTION

PROPERTY DESCRIPTION NO. REPAIR
OWNER OR CONTRACTOR ERVIN BRAWLEY DATE 10/28/97 TAX MAP NO. REPAIR
ADDRESS 159 WALDEN RIDGE LANE MOORESVILLE, NC. 28115 PHONE: Business 892-2119 Home Watershed: [X] Yes [ ] No
LOCATION 136S JUST PAST COOLECREEK STORE TL ON WALDEN RIDGE RD, LEFT FORK TO HOUSE
SUBDIVISION BLOCK / SECTION LOT LOT AREA SITE CLASS. DESIGN FLOW L.T.A.R.

Septic Tank: EXISTING Gallons; STB Date
Pump Tank: Gallons; PT Date
Pump Make: Model Serial No.
Nitrification Field: No Fields 1 Square Feet 900 Linear Feet 300
No Lines 4 Trench Width 36" Max Trench Bottom Depth 36" Gravel Depth 12"

[ ] New System [X] Repair System Type: I, [II], III, IV, V, VI
System Description: CONV TO BULL RUN VALVE
Repair System Description:
Maintenance Agreement Required: [ ] Yes [ ] No


[X] House/Mod. Home No. Bedrooms 3
[ ] Mobile Home No. Bathrooms 2.5
[ ] Business No. Employees
[ ] Other
[ ] Slab [X] Crawl Space [ ] Basement w/plumbing [ ] Basement wo/plumbing

Water Supply: [X] Individual [ ] Community [ ] Public

Comments:

Comments:

INITIAL SITE SKETCH

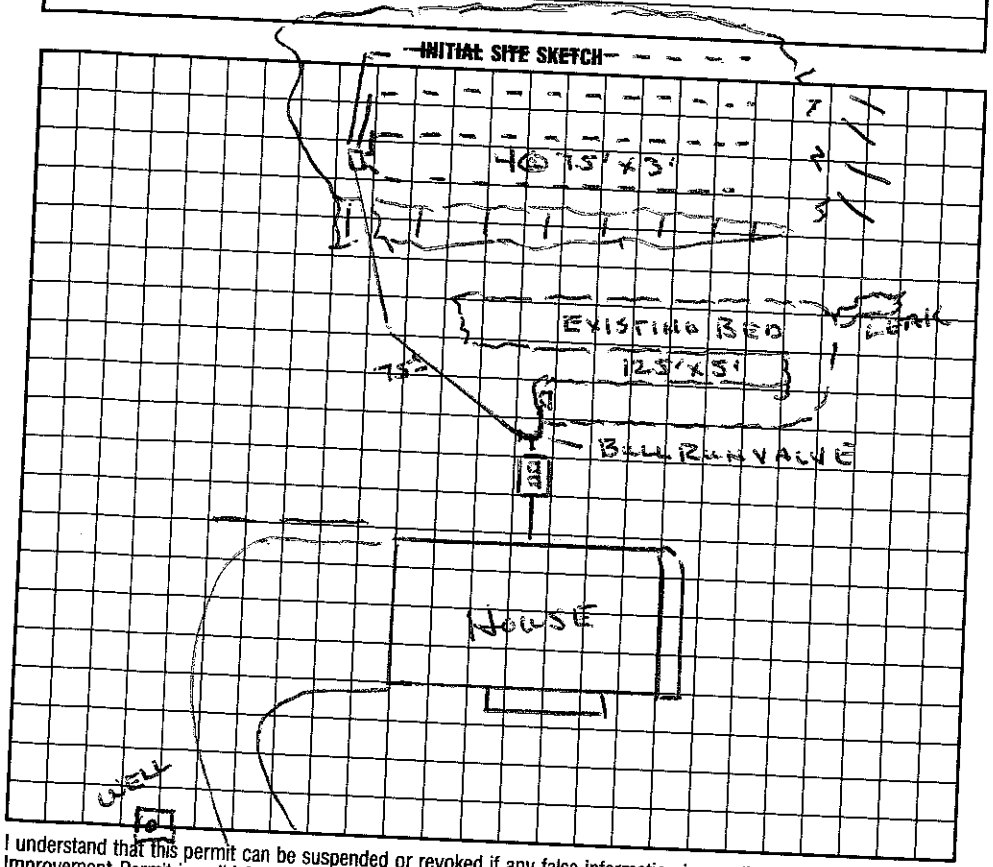

AS BUILT SKETCH

I understand that this permit can be suspended or revoked if any false information is supplied toward securing the permit/any unauthorized changes are made to the site/any unauthorized changes are made in the installation of the system. Improvement Permit is valid for 60 months from date of issuance.

Signed:

Improvement Permit by: Wesley Sparks RS. date 10/28/97
Existing System Inspection by: Wesley Sparks RS. date 10/28/97
Installed by: ABC UNKNOWN
Certificate of Completion by: date
Operation Permit by: date 2/4/98

HEALTH DEPT. COPY: WHITE INSPECTION COPY (FINAL): GREEN OWNER COPY (FINAL): YELLOW INSPECTION COPY (INITIAL): PINK OWNER COPY (INITIAL): GOLD