IREDELL COUNTY HEALTH DEPARTMENT

4660 013834

STATESVILLE 704-878-5305 MOORESVILLE 704-664-5281

B 630 2-00-2:x

IMPROVEMENT PERMIT / CERTIFICATE OF COMPLETION / OPERATION PERMIT / EXISTING SYSTEM INSPECTION

PROPERTY DESCRIPTION NO. REPAIR DATE 6/13/97 TAX MAP NO. REPAIR

OWNER OR CONTRACTOR CLAY SHOLAR PHONE: Business Watershed: ☐ Yes ☑ No

ADDRESS 1740 LANDS HWY - MOORESVILLE NC 28115 - (PO BOX 1395 MOORESVILLE NC 28115) Home 663-6722

LOCATION MAIN ST. TO # 1740 ON RT BEFORE JUNCTION OF 152

SUBDIVISION — BLOCK / SECTION — LOT — LOT AREA ~1 AC SITE CLASS. PS DESIGN FLOW 450 GPD L.T.A.R. —

Septic Tank: 1000 Gallons; STB 794 Date 6/20/97

Pump Tank: Gallons; PT Date

Pump Make: Model Serial No.

Nitrification Field: No Fields 1 Square Feet 900 Linear Feet 225

No Lines 3 Trench Width 12' Max Trench Bottom Depth AS NEEDED Gravel Depth 12"

☑ New System ☐ Repair System Type: I (II) III, IV, V, VI

System Description: GRAVITY CONVENTIONAL

Repair System Description: S

Maintenance Agreement Required: ☐ Yes ☑ No

☑ House/Mod. Home No. Bedrooms 4

☐ Mobile Home No. Bathrooms 2.0

☐ Business No. Employees

☐ Other


☐ Slab ☑ Crawl Space ☐ Basement w/plumbing ☐ Basement wo/plumbing

Water Supply: ☑ Individual ☐ Community ☐ Public

Comments: SET NEW TANK IN PLACE OF OLD TANK.

Comments:

INITIAL SITE SKETCH

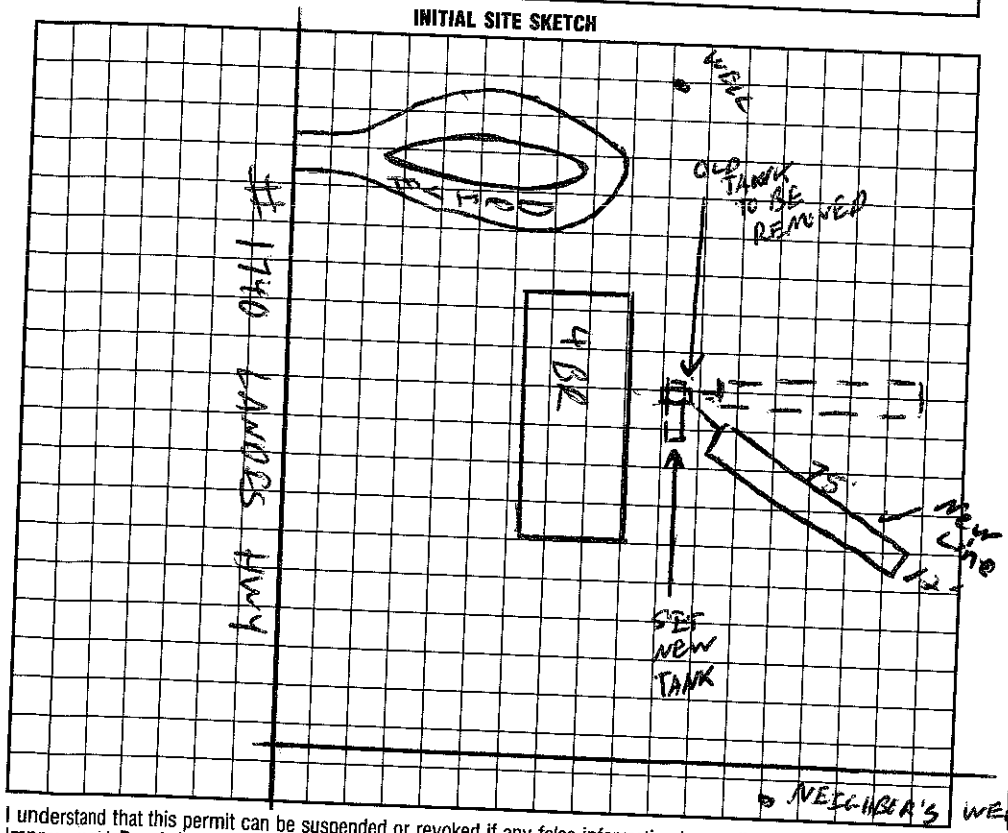

AS BUILT SKETCH

SAME AS Sketch

I understand that this permit can be suspended or revoked if any false information is supplied toward securing the permit/any unauthorized changes are made to the site/any unauthorized changes are made in the installation of the system. Improvement Permit is valid for 60 months from date of issuance.

Signed: Clay Sholar

Improvement Permit by: C. [signature] date 6/13/97

AUTHORIZATION

Existing System Inspection by: C. [signature] date 6/13/97

CONSENT

Installed by: JULIAN BOWLES.

Certificate of Completion by: date

Operation Permit by: C. [signature] date 8/14/97

HEALTH DEPT. COPY: WHITE INSPECTION COPY (FINAL): GREEN OWNER COPY (FINAL): YELLOW INSPECTION COPY (INITIAL): PINK OWNER COPY (INITIAL): GOLD