4667196087

Authorization to Construct Bldg. Permit #63426 878-3171 Darlene

IREDELL COUNTY HEALTH DEPARTMENT

STATESVILLE 704-878-5305 MOORESVILLE 704-664-5281

IMPROVEMENT PERMIT / CERTIFICATE OF COMPLETION / OPERATION PERMIT / EXISTING SYSTEM INSPECTION

PROPERTY DESCRIPTION NO. 3848 DATE 8/29/96 TAX MAP NO. Pt of 1M A 29 Watershed: ☐ Yes ☒ No

OWNER OR CONTRACTOR William Mullen PHONE: Business _____ Home 662-3762

ADDRESS 745 McKendree Rd. Mooresville, NC 28115

LOCATION 150 E X 115-21N on left before before 2ND Railroad Tracks

SUBDIVISION _____ BLOCK / SECTION _____ LOT _____ LOT AREA 2.91 AC SITE CLASS PS DESIGN FLOW 100 L.T.A.R. .3

Septic Tank: 1000 Gallons; STB 794 Date 10/11/96

Pump Tank: _____ Gallons; PT _____ Date _____

Pump Make: _____ Model _____ Serial No. _____

Nitrification Field: No Fields 1 Square Feet 333 Linear Feet 115

No Lines 192 Trench Width 36" Max Trench Bottom Depth 36" Gravel Depth 12"

☒ New System ☐ Repair System Type: I. II III. IV. V. VI

System Description: Gravo-Conventional

Repair System Description: Same

Maintenance Agreement Required: ☐ Yes ☒ No

~~☒ House/Mob. Home~~ No. Bedrooms ____

☐ Mobile Home No. Bathrooms ____

☐ Business No. Employees ____

☒ Other 2 Employees/25600

☒ Slab ☐ Crawl Space ☐ Basement w/plumbing ☐ Basement wo/plumbing


Water Supply:
☐ Individual
☒ Community
☐ Public
MOORESVILLE

Comments:


Comments:

3601

INITIAL SITE SKETCH

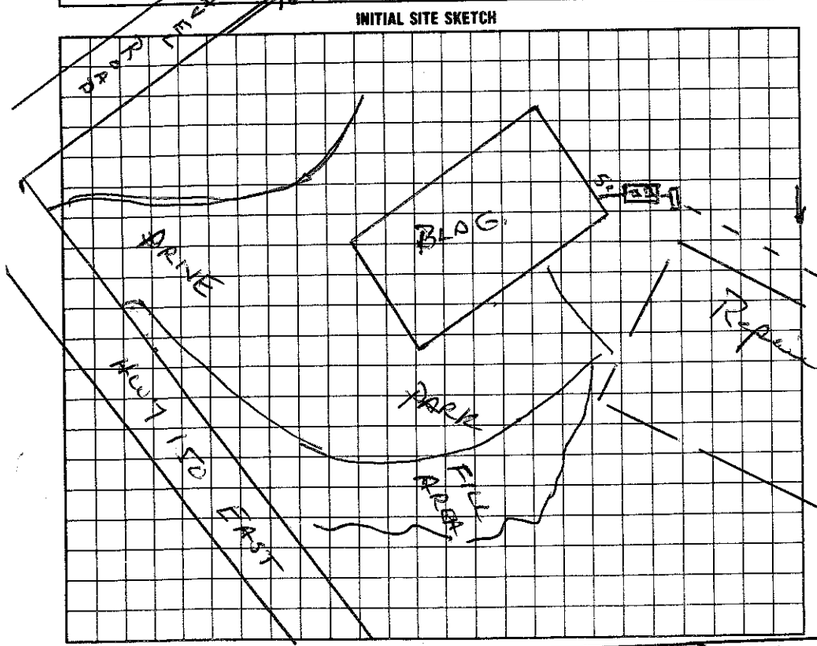

AS BUILT SKETCH

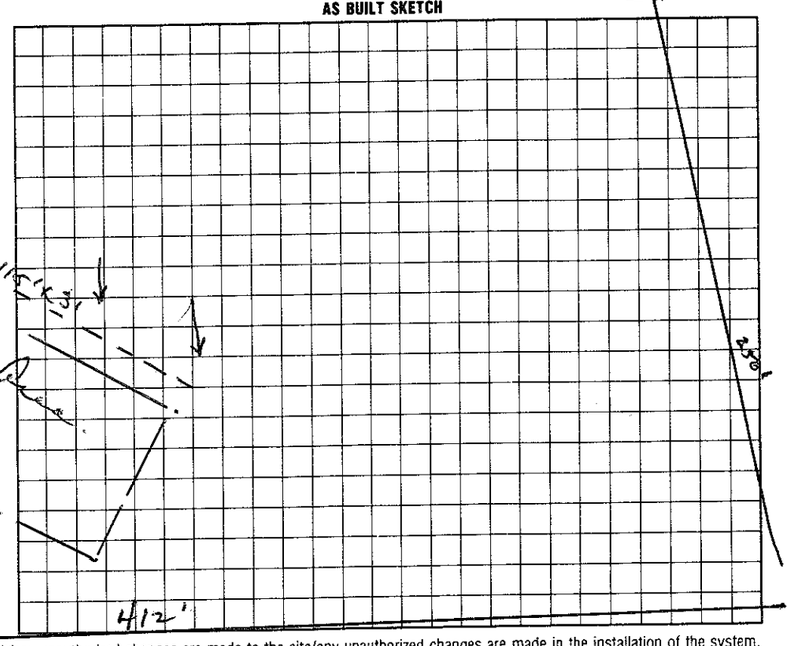

I understand that this permit can be suspended or revoked if any false information is supplied toward securing the permit/any unauthorized changes are made to the site/any unauthorized changes are made in the installation of the system.

Signed: William Mullen

Improvement Permit by: Wesley Sparks RS. date 8/26/96

Existing System Inspection by: Wesley Sparks RS. date 8/29/96

Installed by: A Carolina Backhoe

Certificate of Completion by: _____ date _____

Operation Permit by: Wesley Sparks RS. date 11/14/96

HEALTH DEPT. COPY: WHITE INSPECTION COPY (FINAL): GREEN OWNER COPY (FINAL): YELLOW INSPECTION COPY (INITIAL): PINK OWNER COPY (INITIAL): GOLD