IREDELL COUNTY HEALTH DEPARTMENT

Authorization to Construct

STATESVILLE 704-878-5305 MOORESVILLE 704-664-5281

IMPROVEMENT PERMIT / ~~CERTIFICATE OF COMPLETION~~ / OPERATION PERMIT / EXISTING SYSTEM INSPECTION

PROPERTY DESCRIPTION NO. 5007 DATE 8/26/97 TAX MAP NO. 4667198832 4667198702 Watershed: X Yes ☐ No

OWNER OR CONTRACTOR GL WILSON BLDG CO [LAKE NORMAN ENGINEERING] PHONE: Business WILSON- 872-2411 Home

ADDRESS 615 CABARRUS AVE. MOORESVILLE, NC. 28115

LOCATION 150E TL GOODWIN CIRCLE, TL FIRST DRIVE, UPHILL TO BUILDING

SUBDIVISION VELMA ERVIN BLOCK / SECTION — LOT LOT AREA 3.55 Ac SITE CLASS. PS DESIGN FLOW 300 L.T.A.R. .275

Septic Tank: 1000 Gallons; STB 794 Date 10/24/97

Pump Tank: 1000 Gallons; PT 27 Date 2/16/98

Pump Make: HYDROMATIC Model SHEF33A-1 Serial No. 11/97

Nitrification Field: No Fields 1 Square Feet 1090 Linear Feet 363

No Lines 3 Trench Width 36" Max Trench Bottom Depth 36" Gravel Depth 12"

X New System ☐ Repair System Type: I, II, (III), IV, V, VI

System Description: PressMan → CONVENTIONAL

Repair System Description: CH PLASTIC OR HOS

Maintenance Agreement Required: ☐ Yes X No

☐ House/Mod. Home ☐ Mobile Home X Business ☐ Other

No. Bedrooms ___ No. Bathrooms ___ No. Employees 12


X Slab ☐ Crawl Space ☐ Basement w/plumbing ☐ Basement wo/plumbing

Water Supply: X Individual ☐ Community ☐ Public FABRFIL


Comments: Pressure Manifold (4") with protective box required

Comments:

INITIAL SITE SKETCH

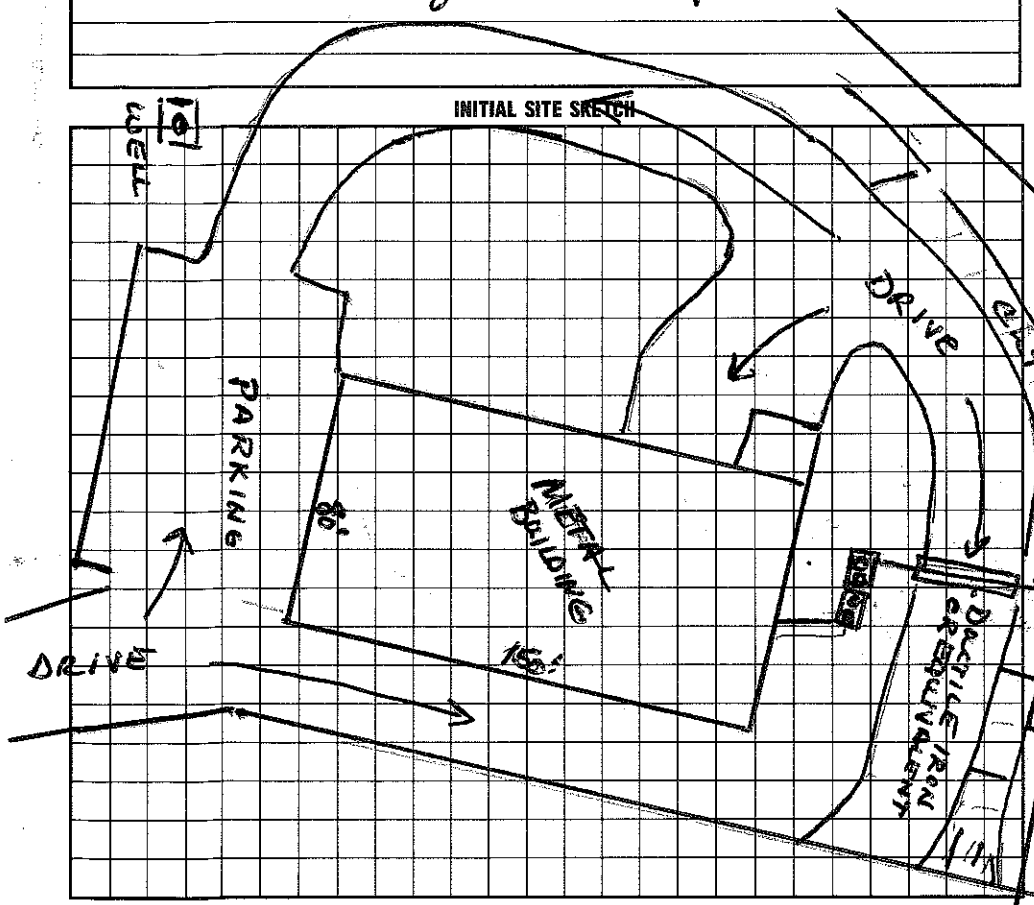

AS BUILT SKETCH

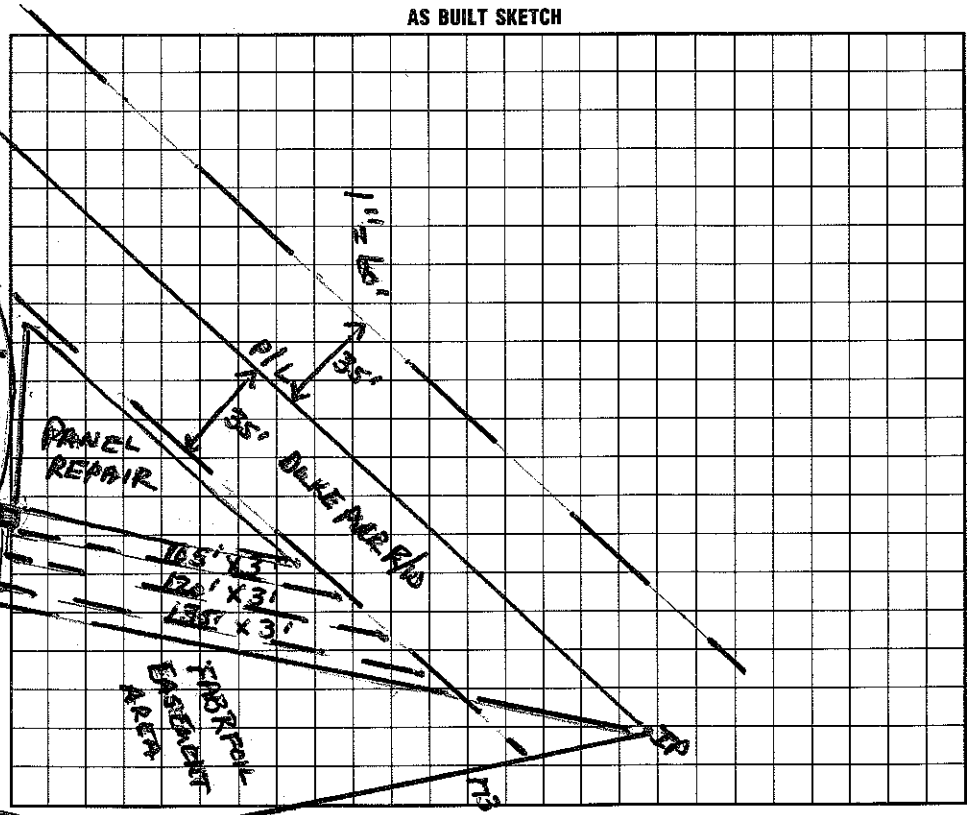

I understand that this permit can be suspended or revoked if any false information is supplied toward securing the permit/any unauthorized changes are made to the site/any unauthorized changes are made in the installation of the system. Improvement Permit is valid for 60 months from date of issuance.

Signed: X

Improvement Permit by: Wesley Sparks RS. date 8/26/97

Existing system inspection by: Wesley Sparks RS. date 8/26/97

Installed by: James Hudson

Certificate of Completion by: Wesley Sparks RS. date 5/21/98

Operation Permit by: Wesley Sparks RS. date 5/21/98

Authorized

HEALTH DEPT. COPY: WHITE INSPECTION COPY (FINAL): GREEN OWNER COPY (FINAL): YELLOW INSPECTION COPY (INITIAL): PINK OWNER COPY (INITIAL): GOLD