IREDELL COUNTY HEALTH DEPARTMENT

STATESVILLE 704-878-5305 MOORESVILLE 704-664-5281

IMPROVEMENT PERMIT / AUTHORIZATION TO CONSTRUCT / OPERATION PERMIT / EXISTING SYSTEM INSPECTION

PERMIT# 116416 PIN# 4667964643 4667-21-6810 DATE 1/9/04

OWNER OR CONTRACTOR TOWN OF MOORESVILLE - REC DEPT. PHONE: Business 663-2801 Home

ADDRESS 220 N MAPLE ST MOORESVILLE

LOCATION MAIN ST. EAST - BETWEEN CEDAR CROFT & 150

SUBDIVISION NEEL TRACT PK BLOCK / SECTION LOT - LOT AREA 10.69AC SITE CLASS. PS DESIGN FLOW 1380 L.T.A.R. ~3 GPD/FT

Septic Tank: 3000 Gallons; STB Date 4/30/04

Pump Tank: 3000 Gallons; PT 156 Date 4/21/04

Pump Make: Model Serial No.

Nitrification Field: No Fields 1 Square Feet @3204 Linear Feet 1068

No Lines 6@178' Trench Width 36" Max Trench Bottom Depth 36" Gravel Depth

☑ New System ☐ Repair System Type: I, II, (III), IV, V, VI

System Description: PUMP 25% REDUCTION

Repair System Description: SAME

Maintenance Agreement Required: ☐ Yes ☑ No

☐ House/Mod. Home No. Bedrooms

☐ Mobile Home No. Bathrooms

☐ Business No. Employees

☑ Other PARK 115 PARKING SPACES

☑ Slab ☑ Crawl Space ☐ Basement w/plumbing ☐ Basement wo/plumbing

Water Supply: ☐ Individual ☑ Public ☐ Community

Comments:/Conditions: NO FOOD SERVICE.

Comments:/Conditions:

INITIAL SITE SKETCH

SEE PIEDMONT DESIGN & ASS. PLAN.

AS BUILT SKETCH

Permit can be suspended or revoked if any false information is supplied toward securing the permit/any unauthorized changes are made to the site/any unauthorized changes are made in the installation of the system. Improvement Permit with plat valid without expiration. Improvement Permit with site plan valid for sixty months. Authorization to Construct is valid for a period equal to that of Improvement Permit – not to exceed sixty months.

Signed: Jay H. Digh Jr date 1/9/04

Improvement Permit by: RS date 1/9/04

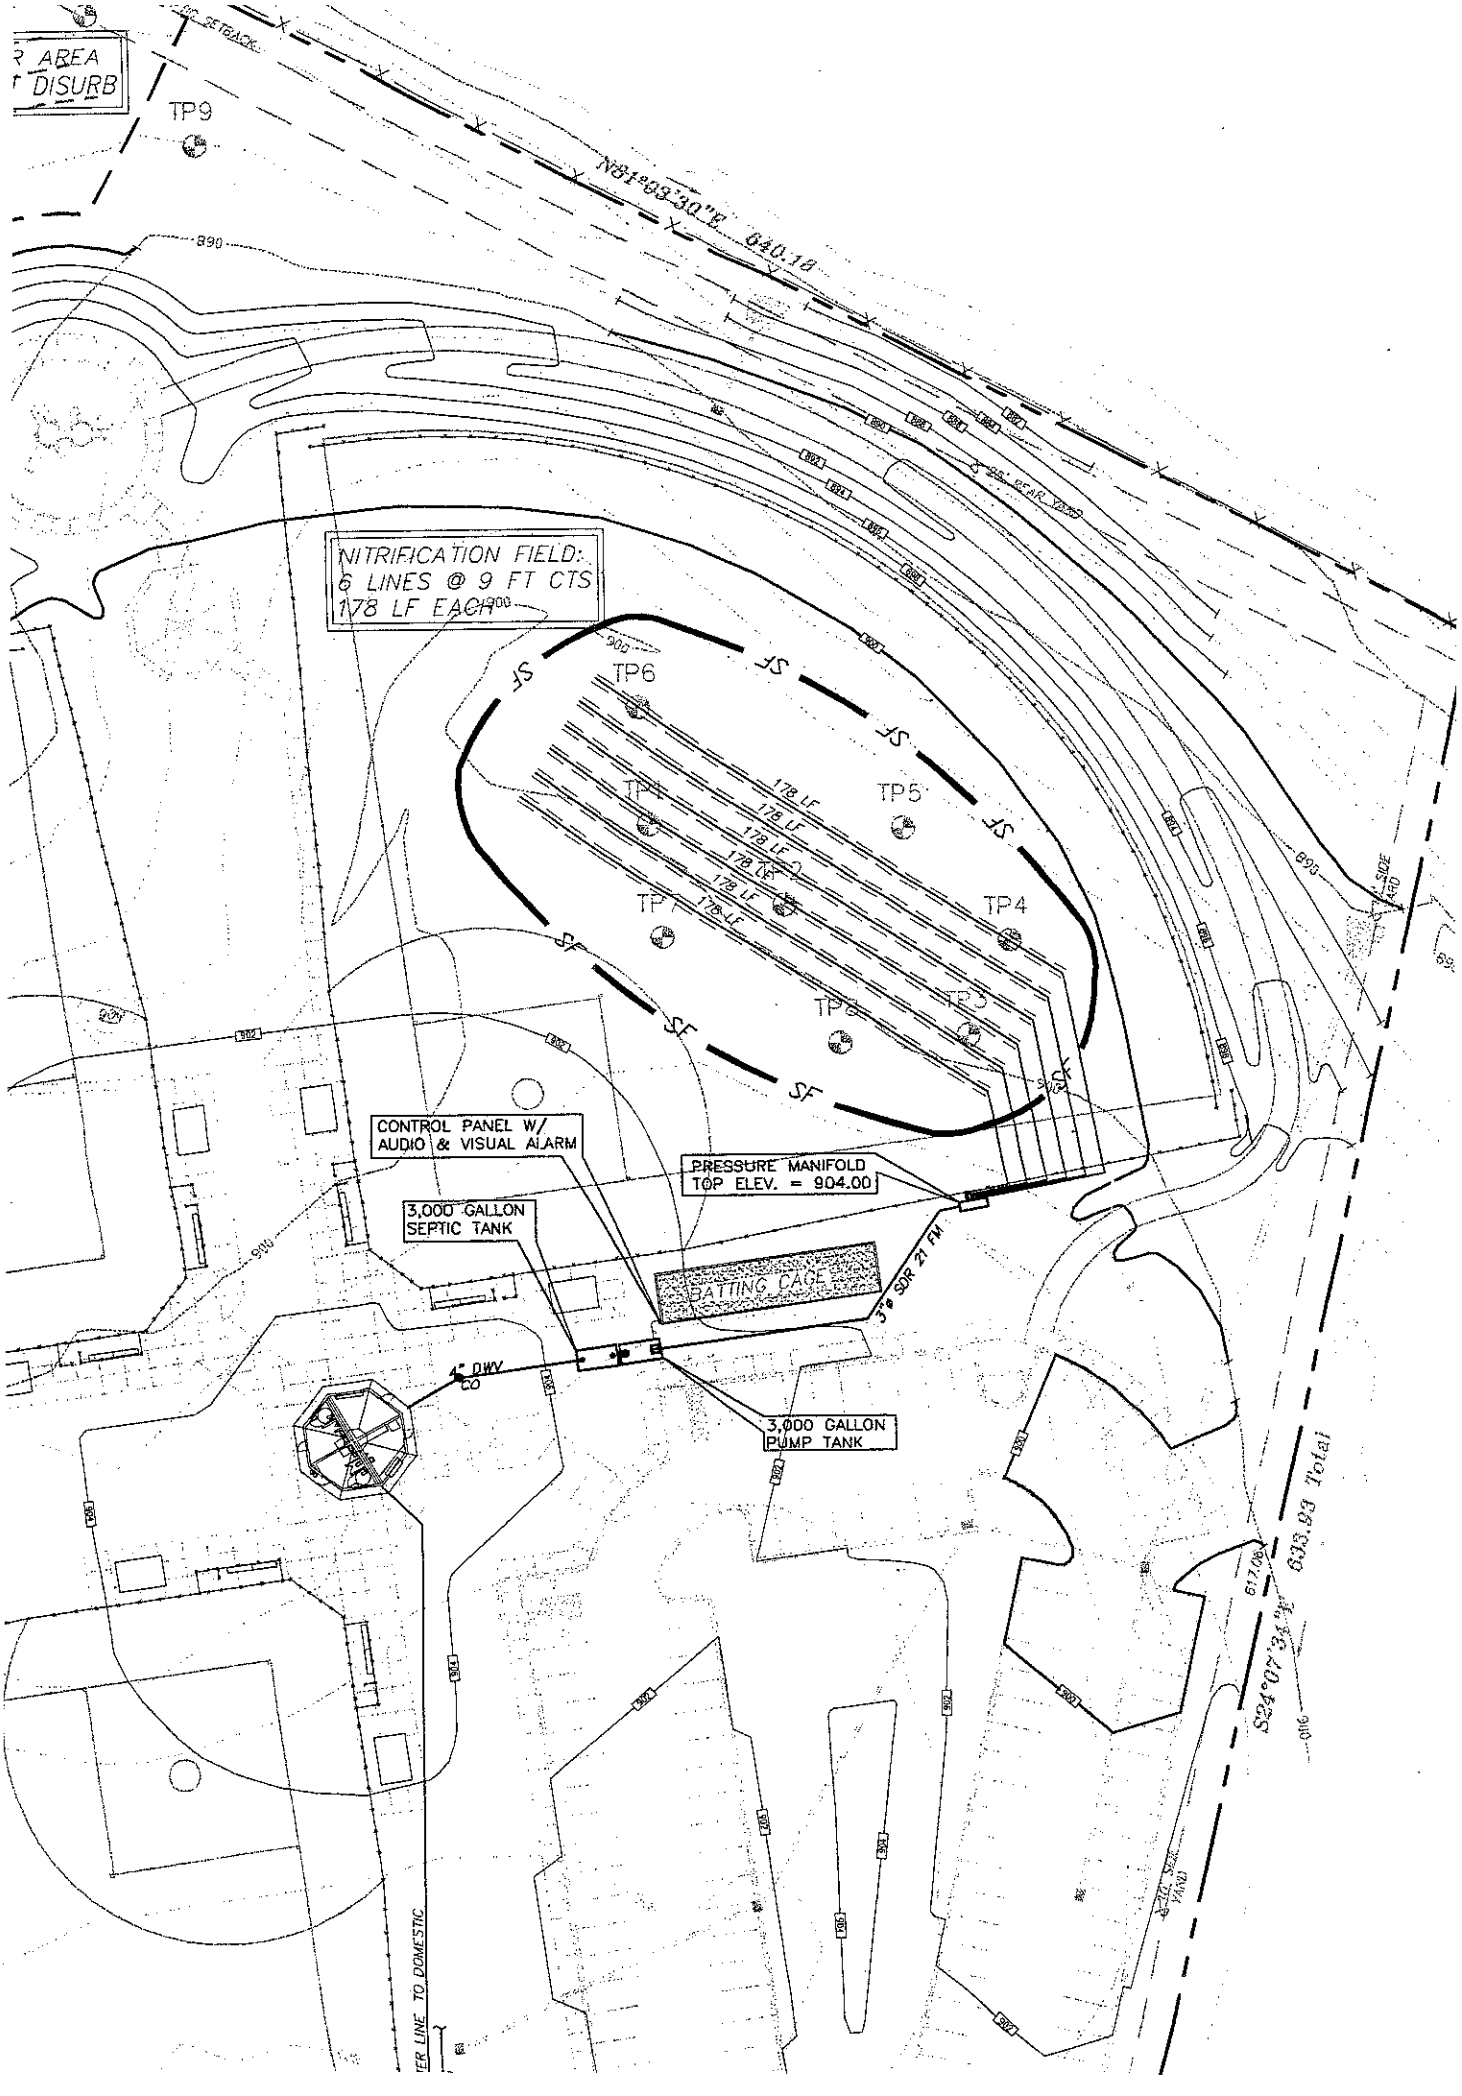
Authorization to Construct by: RS date 1/9/04

Installed by: A1 Nichols

Operation Permit by: RS date 11/21/05

Existing System Inspection by: date

HEALTH DEPT. COPY: WHITE OWNER COPY (FINAL): YELLOW OWNER COPY (INITIAL): PINK


R AREA
DISURB
TP9
N81°03'30"E 640.18
NITRIFICATION FIELD:
6 LINES @ 9 FT CTS
178 LF EACH
TP6
TP5
TP4
TP3
TP2
TP1
178 LF
CONTROL PANEL W/
AUDIO & VISUAL ALARM
PRESSURE MANIFOLD
TOP ELEV. = 904.00
3,000 GALLON
SEPTIC TANK
BATTING CAGE
3" SDR 21 FM
4" DWV
CO
3,000 GALLON
PUMP TANK
S24°07'34"E 633.83 Total
ER LINE TO DOMESTIC