IREDELL COUNTY HEALTH DEPARTMENT

STATESVILLE 704-878-5305 MOORESVILLE 704-664-5281

IMPROVEMENT PERMIT / AUTHORIZATION TO CONSTRUCT / OPERATION PERMIT / EXISTING SYSTEM INSPECTION

PERMIT# 5355 PIN# 4667390080 DATE 1/29/98

OWNER OR CONTRACTOR UNICON CONCRETE PHONE: Business 872-9566 Home

ADDRESS PO BOX 1835 STATESVILLE NC 28687

LOCATION 115 N - TR 150 E - TR FIRST DIRT RD - AT END

SUBDIVISION — BLOCK / SECTION — LOT — LOT AREA 14.19AC SITE CLASS. PS DESIGN FLOW 1650GD L.T.A.R. .3 GPD/FT²

Septic Tank: 1000 Gallons; STB 1012 Date 3/31/98
Pump Tank: ____ Gallons; PT ____ Date ____
Pump Make: ____ Model ____ Serial No. ____
Nitrification Field: No. Fields 1 Square Feet 600 Linear Feet 200
No Lines 4@50 Trench Width 36" Max Trench Bottom Depth 24" Gravel Depth 12"

☑ New System ☐ Repair System Type: I, II, III, IV, V, VI
System Description: GRAVITY CONVENTIONAL
Repair System Description: SAME
Maintenance Agreement Required: ☐ Yes ☑ No


☐ House/Mod. Home No. Bedrooms ____
☐ Mobile Home No. Bathrooms ____
☑ Business No. Employees 7
☐ Other ____
☑ Slab ☐ Crawl Space ☐ Basement w/plumbing ☐ Basement wo/plumbing

Water Supply:
☑ Individual
☐ Public
☐ Community


Comments:/Conditions:

Comments:/Conditions:

INITIAL SITE SKETCH ~ 1:200

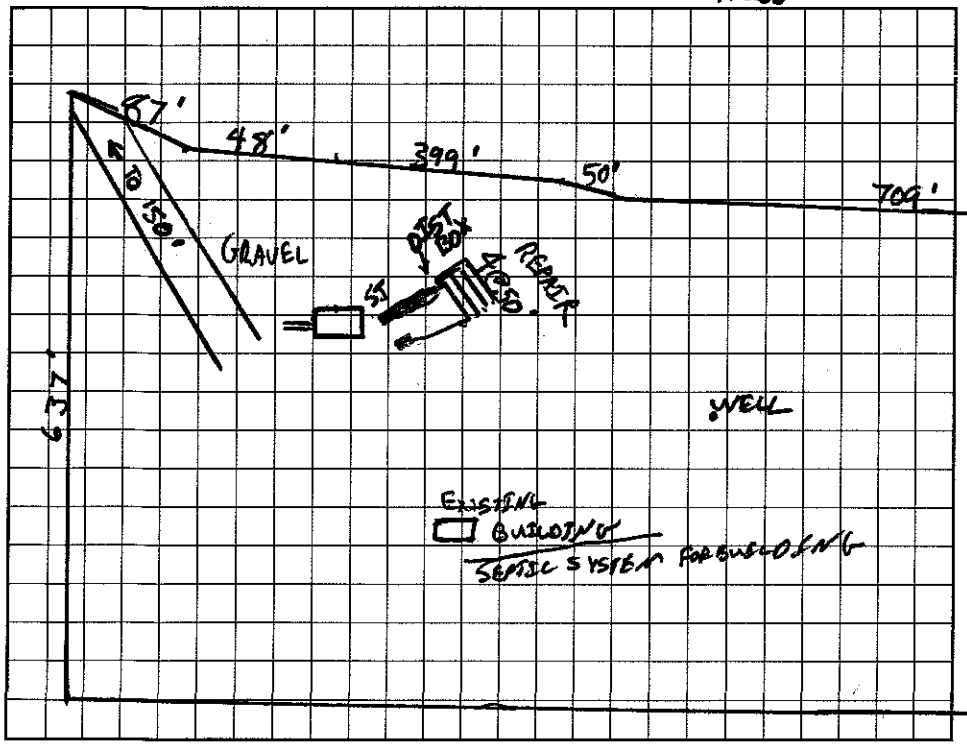

AS BUILT SKETCH

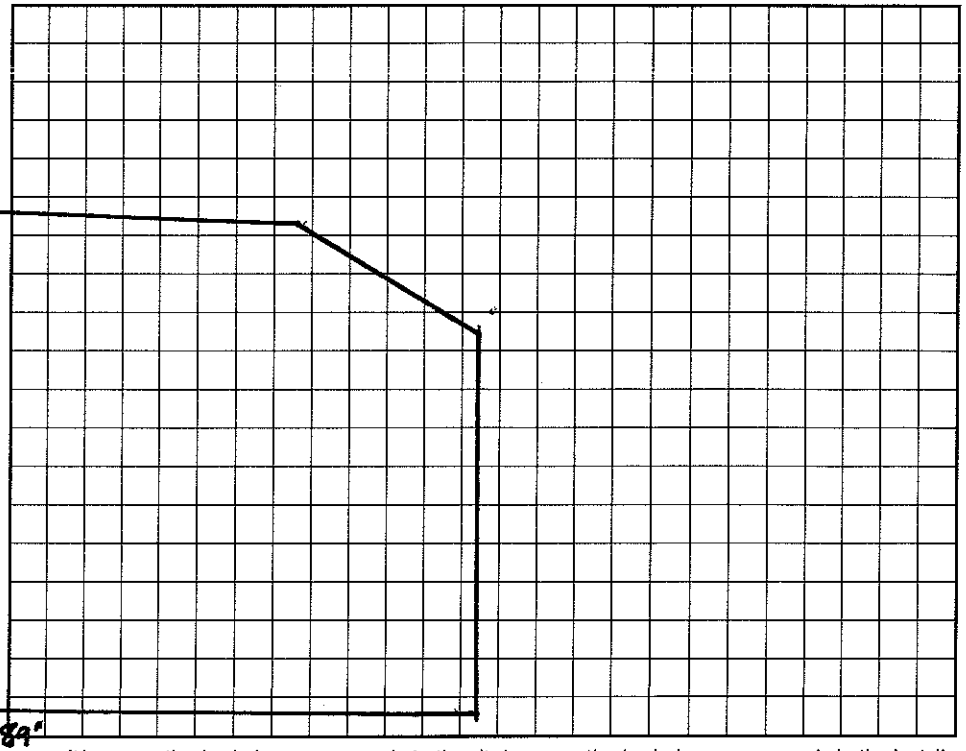

I understand that this permit can be suspended or revoked if any false information is supplied toward securing the permit/any unauthorized changes are made to the site/any unauthorized changes are made in the installation of the system. Improvement Permit with plat valid without expiration. Improvement Permit with site plan valid for sixty months. Authorization to Construct is valid for a period equal to that of Improvement Permit – not to exceed sixty months.

Signed: ____ date 1/29/98 Installed by: DAVID YONTZ

Improvement Permit by: C. Ray Freeman RS date 1/29/98 Operation Permit by: C. Ray Freeman date 6/9/98

Authorization to Construct by: C. Ray Freeman RS date 1/29/98 Existing System Inspection by: ____ date ____

HEALTH DEPT. COPY: WHITE INSPECTION COPY (FINAL): GREEN OWNER COPY (FINAL): YELLOW INSPECTION COPY (INITIAL): PINK OWNER COPY (INITIAL): GOLD