IREDELL COUNTY HEALTH DEPARTMENT

STATESVILLE 704-878-5305 MOORESVILLE 704-664-5281

IMPROVEMENT PERMIT / AUTHORIZATION TO CONSTRUCT / OPERATION PERMIT / EXISTING SYSTEM INSPECTION

PERMIT # 159773 PIN # 4667739781 DATE 3/11/10

OWNER or APPLICANT Jeremy Day PHONE: Business / Home: 704-662-3581

OWNER or APPLICANT ADDRESS 1662 Linwood Rd

LOCATION / DIRECTIONS Same, main st, move ® on Linwood Rd, on right (app. 10 min)

SUBDIVISION Hillcrest BLOCK / SECTION LOT # 35 LOT AREA .203 DESIGN FLOW existing L.T.A.R. existing

Septic Tank existing Gallons: STB existing Date existing

Pump Tank N/A Gallons: P T Date

Pump Make Model Serial #

Nitrification Field No Fields No Lines Linear Feet

Trench Width Max. Trench Bottom Depth Gravel Depth

☐ New System ☐ Repair ☐ Expansion System Type I II III IV V VI

System Description: existing

Repair System Description: 15A NCAC 18A .1945

Maintenance Agreement Required ☐ YES ☐ NO

☑ GRAVITY ☐ PRESSURE

☑ Residence No. Bedrooms 2

☐ Business No. Persons

☐ Other No. Employees

☐ Slab ☑ Crawl Space


☐ Basement w/plumbing ☐ Basement w/o plumbing

Water Supply: ☐ Private ☑ Public ☐ Community


Comments / Conditions: All setback requirements must be maintained. No bedrooms are being added as indicated by floor plan. System appears to be functioning properly at time of existing system inspection.

Comments / Conditions: Proposed Addition does not encroach on Septic System.

INITIAL SITE SKETCH

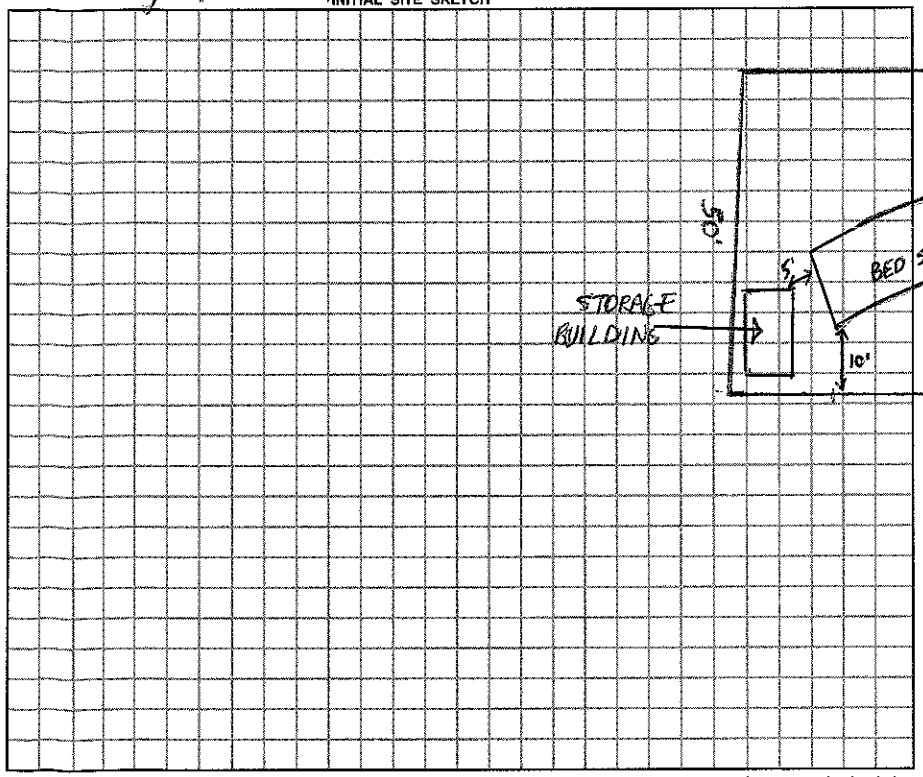

AS BUILT SKETCH

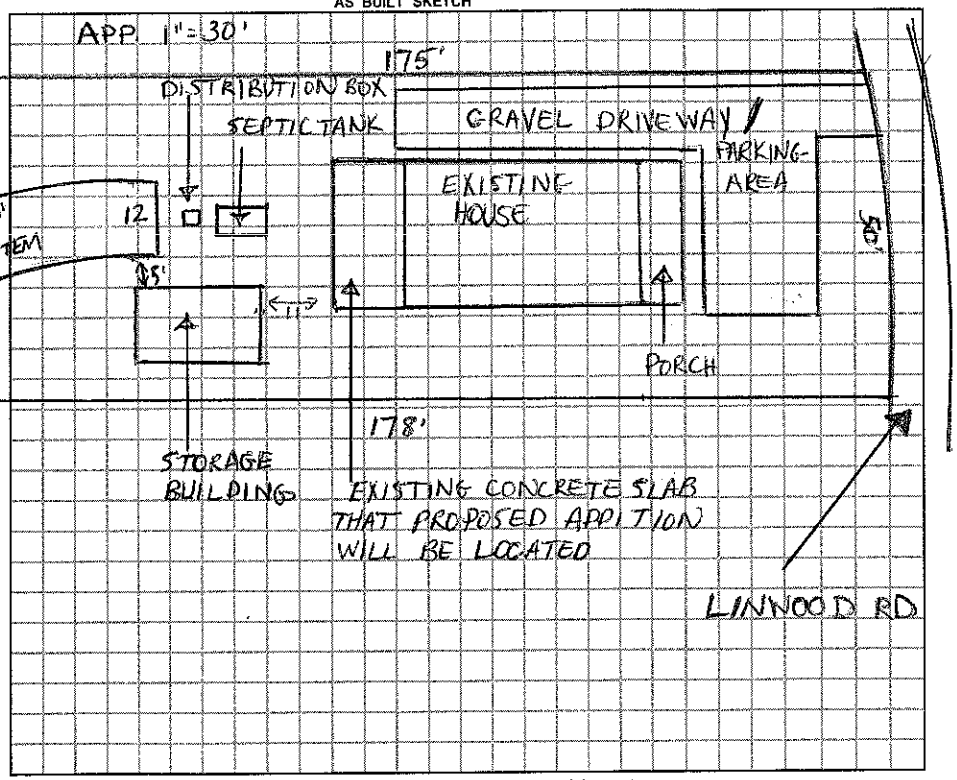

Permit can be suspended or revoked if any false information is supplied toward securing the permit / any unauthorized changes are made to the site / any unauthorized changes are made in the installation of the system.

☐ *IMPROVEMENT PERMIT w / plat valid without expiration.* ☐ *IMPROVEMENT PERMIT w / site plan valid for 60 mos.* ☐ *AUTHORIZATION TO CONSTRUCT valid for period equal to IMPROVEMENT PERMIT-not to exceed 60 mo.*

Owner / Applicant Signature: [signature] Date 3/11/10

Improvement Permit by: Date

Authorzation to Construct by: Date

YOU SHOULD CONTACT A LOCATOR SERVICE PRIOR TO ANY EXCAVATION.

Installed by:

Operation Permit by: Date:

Existing System Inspected by: Kyle Ball, REHS Date: 3/11/10

WHITE COPY Environmental Health YELLOW COPY (Final) Owner / Applicant PINK COPY (Initial) Owner / Applicant