IREDELL COUNTY HEALTH DEPARTMENT

Authorization to Construct

STATESVILLE 704-878-5305 MOORESVILLE 704-664-5281

1136

IMPROVEMENT PERMIT / ~~CERTIFICATE OF COMPLETION~~ / OPERATION PERMIT / EXISTING SYSTEM INSPECTION

PROPERTY DESCRIPTION NO 03404 ~~21769~~ DATE 10/2/97 TAX MAP NO. 4667-85 ~~1BA49~~ 1597 Watershed: ☐ Yes ☒ No

OWNER OR CONTRACTOR Mack + Beth Ann Puckett PHONE: Business _____ Home 896-8959

ADDRESS PO Box 1782 Davidson, NC. 28036

LOCATION Sheeners Rd on L past Lefler Belle Glade Subdivision

SUBDIVISION _____ BLOCK / SECTION _____ LOT _____ LOT AREA ~2.2AC SITE CLASS. PS DESIGN FLOW 480 L.T.A.R. .25

Septic Tank: 1000 Gallons; STB 1012 Date 7/23/98

Pump Tank: 1000 Gallons; PT 17 Date 7/10/98

Pump Make: MEYERS Model ME40 Serial No. -

Nitrification Field: No Fields 1 Square Feet 1920 Linear Feet 640

No Lines 4 Trench Width 36" Max Trench Bottom Depth 36" Gravel Depth 12"

☒ New System ☐ Repair System Type: I, II, (III) IV, V, VI

System Description: PressMan - Conventional

Repair System Description: SAME

Maintenance Agreement Required: ☐ Yes ☒ No

☒ House/Mod. Home No. Bedrooms 4

☐ Mobile Home No. Bathrooms 5

☐ Business No. Employees ____

☐ Other _____


☐ Slab ☐ Crawl Space ☒ Basement w/plumbing ☐ Basement wo/plumbing

Water Supply: ☒ Individual ☐ Community ☐ Public


Comments:

Comments:

INITIAL SITE SKETCH

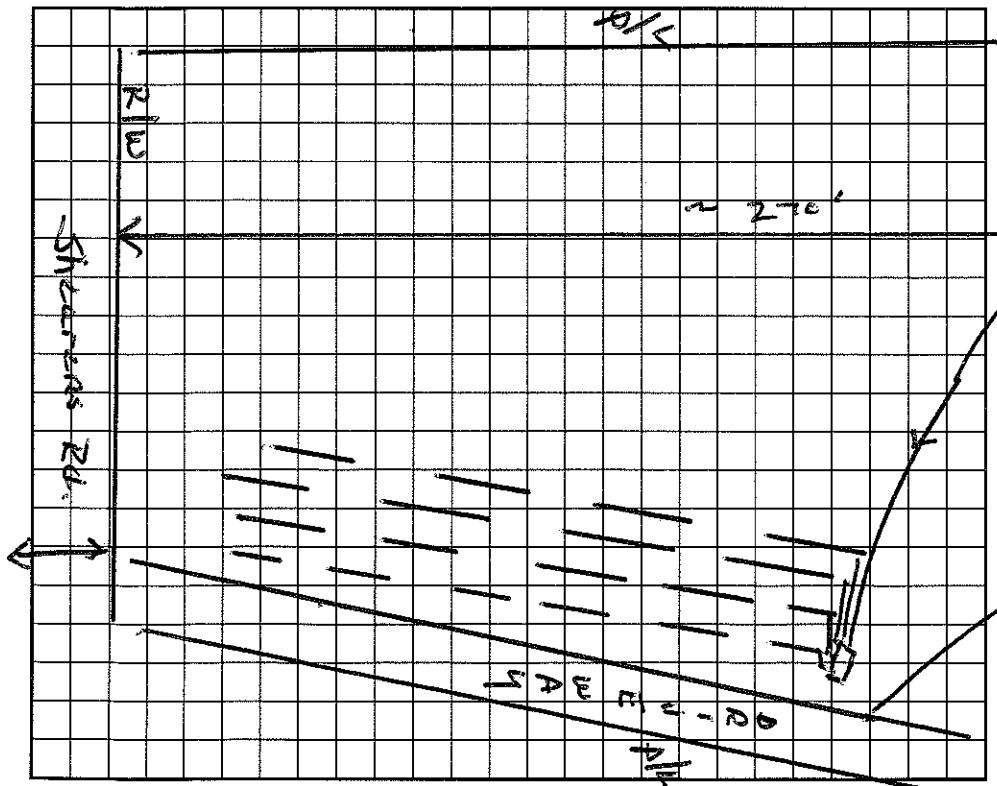

AS BUILT SKETCH

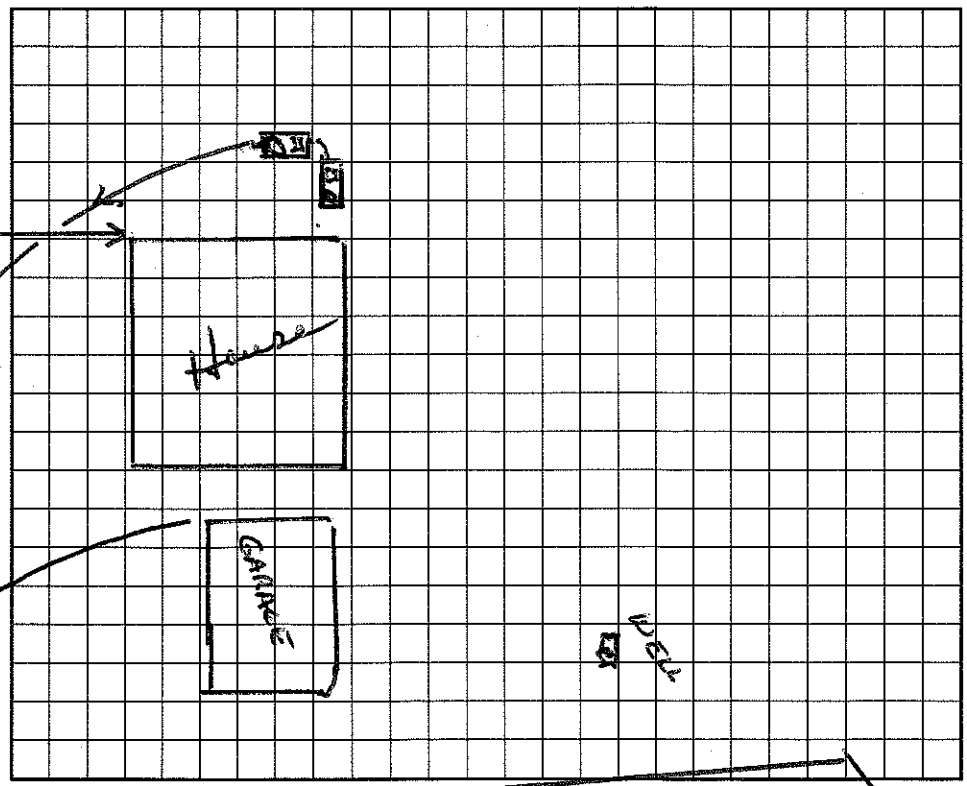

I understand that this permit can be suspended or revoked if any false information is supplied toward securing the permit/any unauthorized changes are made to the site/any unauthorized changes are made in the installation of the system. Improvement Permit is valid for 60 months from date of issuance.

Signed: ~~X~~ Mack Puckett

Improvement Permit by: Wesley Sparks R.S. date 10/2/97

Existing System Inspection by: Wesley Sparks R.S. date 10/2/97

Installed by: ABERNATHY

Certificate of Completion by: Wesley Sparks R.S. date 11/24/03

Operation Permit by: _____ date _____

HEALTH DEPT. COPY: WHITE INSPECTION COPY (FINAL): GREEN OWNER COPY (FINAL): YELLOW INSPECTION COPY (INITIAL): PINK OWNER COPY (INITIAL): GOLD