IREDELL COUNTY HEALTH DEPARTMENT

5th AUTHORIZATION TO CONSTRUCT

4667908373

STATESVILLE 704-878-5305 MOORESVILLE 704-664-5281

IMPROVEMENT PERMIT / ~~CERTIFICATE OF COMPLETION~~ / OPERATION PERMIT / EXISTING SYSTEM INSPECTION

PROPERTY DESCRIPTION NO. 4750 - Mooresville Jur DATE 7/30/97 TAX MAP NO. 4667908203 Watershed: ☐ Yes ☐ No

OWNER OR CONTRACTOR MARK DEATON PHONE: Business _____ Home 663-3076

ADDRESS 368 LINWOOD RD MOORESVILLE NC 28115

LOCATION MAIN ST - TR LINWOOD - BEHIND # 368.

SUBDIVISION — BLOCK / SECTION — LOT 7 LOT AREA — SITE CLASS. RS DESIGN FLOW 240 L.T.A.R. .3

Septic Tank: 1000 Gallons; STB 794 Date 7/11/97

Pump Tank: _____ Gallons; PT _____ Date _____

Pump Make: _____ Model _____ Serial No. _____

Nitrification Field: No Fields 1 Square Feet 810 Linear Feet 270

No Lines ~~30~~ 4 Trench Width 36" Max Trench Bottom Depth 24" Gravel Depth 12"

☑ New System ☐ Repair System Type: I, II, III, IV, V, VI

System Description: GRAVITY CONVENTIONAL

Repair System Description: SAME

Maintenance Agreement Required: ☐ Yes ☑ No

☐ House/Mod. Home ☑ Mobile Home ☐ Business ☐ Other

No. Bedrooms 2 No. Bathrooms 2 No. Employees ____


☐ Slab ☑ Crawl Space ☐ Basement w/plumbing ☐ Basement wo/plumbing

Water Supply: ☑ Individual ☐ Community ☐ Public

Comments:

Comments: FROM NEIGHBOR

INITIAL SITE SKETCH 1"=40'

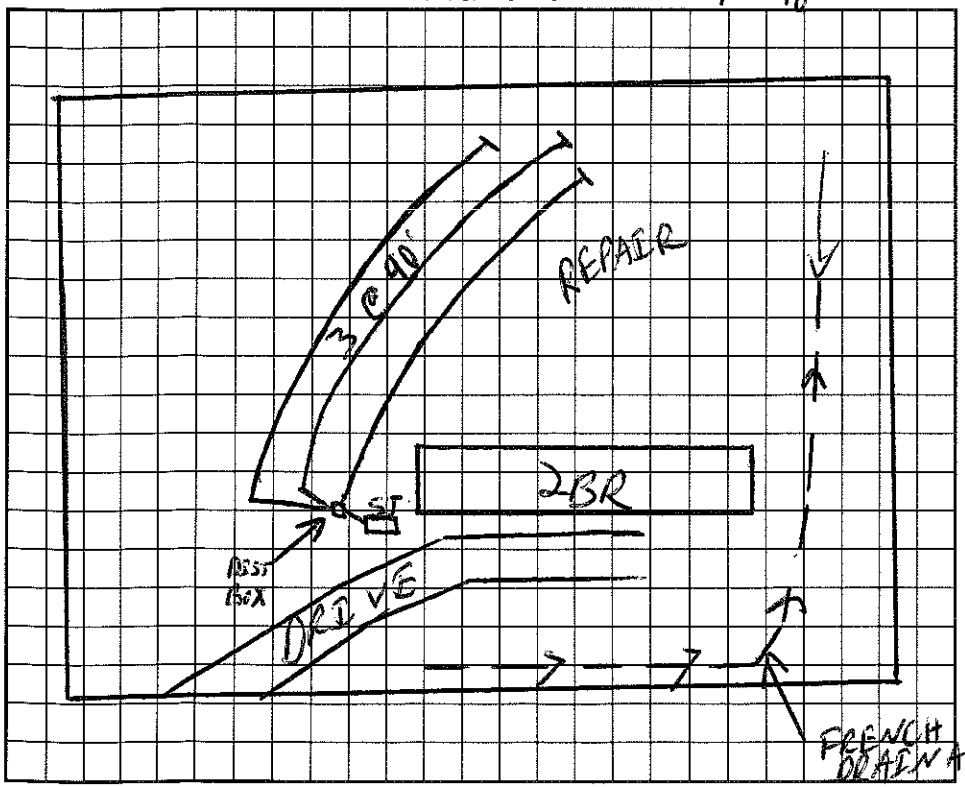

AS BUILT SKETCH

I understand that this permit can be suspended or revoked if any false information is supplied toward securing the permit/any unauthorized changes are made to the site/any unauthorized changes are made in the installation of the system. Improvement Permit is valid for 60 months from date of issuance.

Signed: Jeremy Smith

Improvement Permit by: _____ date 7/30/97

~~Existing System Inspection by:~~ AUTHORIZATION TO CONSTRUCT _____ date 7/30/97

Installed by: Dobson Construction

Certificate of Completion by: Wesley Sparks RS date 9/16/97

Operation Permit by: Wesley Sparks RS. date 9/16/97

HEALTH DEPT. COPY: WHITE INSPECTION COPY (FINAL): GREEN OWNER COPY (FINAL): YELLOW INSPECTION COPY (INITIAL): PINK OWNER COPY (INITIAL): GOLD