IREDELL COUNTY HEALTH DEPARTMENT

STATESVILLE 704-878-5305 MOORESVILLE 704-664-5281

IMPROVEMENT PERMIT / AUTHORIZATION TO CONSTRUCT / OPERATION PERMIT / EXISTING SYSTEM INSPECTION

PERMIT# Repair PIN# 4607923968 DATE 4/2/04

OWNER OR CONTRACTOR Zeb Brawley PHONE: Business Home 704 664 3993

ADDRESS 235 Linwood Rd Mooresville NC 28115

LOCATION Main St. TR Linwood, 1/2 mile on Lt #235

SUBDIVISION BLOCK / SECTION LOT LOT AREA SITE CLASS. AS DESIGN FLOW 240 L.T.A.R.

Septic Tank: Existing Gallons: STB Date

Pump Tank: Gallons: PT Date

Pump Make: Model Serial No.

Nitrification Field: No Fields 1 Square Feet 495 Linear Feet 55'

No Lines 3 Trench Width 9" Max Trench Bottom Depth 36"

☐ New System ☒ Repair System Type: I, II, III, IV, V, VI

System Description: 25% Red

Repair System Description: ~~Conventional~~ Red

Maintenance Agreement Required: ☐ Yes ☒ No

Gravel Depth 12"

☒ House/Mod. Home No. Bedrooms 2

☐ Mobile Home No. Bathrooms 1

☐ Business No. Employees

☐ Other


☐ Slab ☒ Crawl Space ☐ Basement w/plumbing ☐ Basement wo/plumbing

Water Supply:
☒ Individual
☐ Public
☐ Community


Comments:/Conditions:

Comments:/Conditions:

INITIAL SITE SKETCH

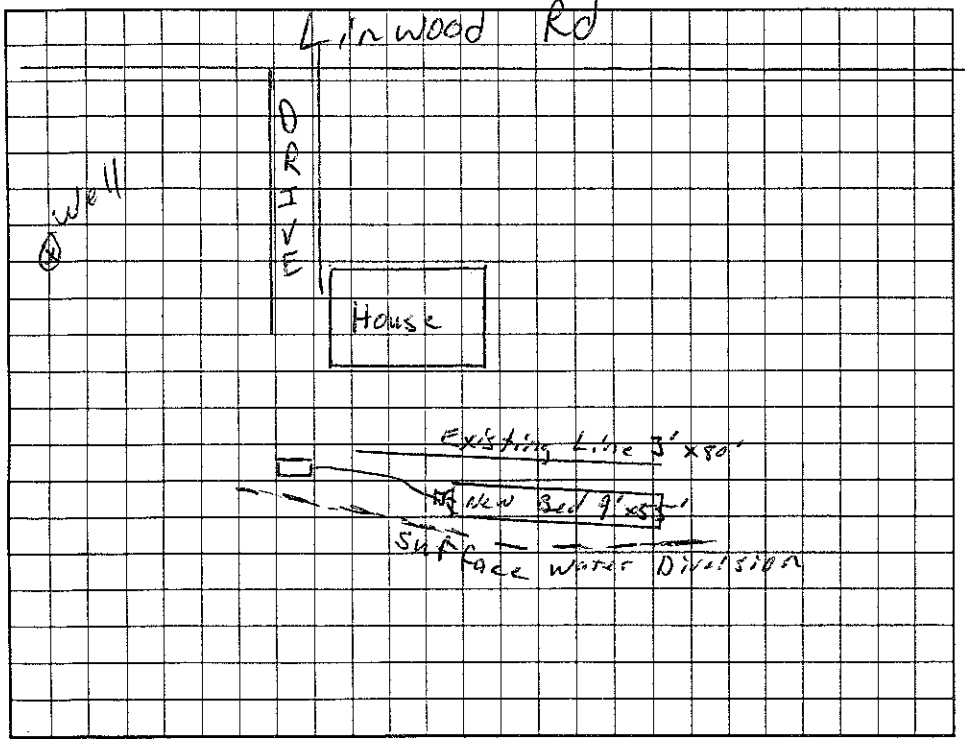

AS BUILT SKETCH

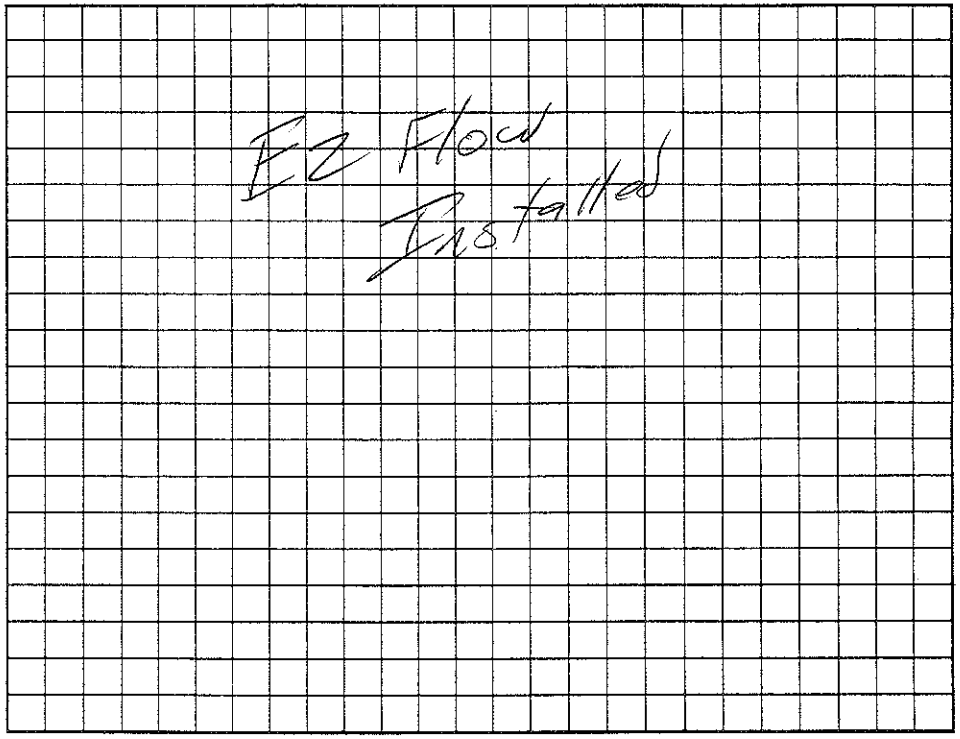

Permit can be suspended or revoked if any false information is supplied toward securing the permit/any unauthorized changes are made to the site/any unauthorized changes are made in the installation of the system. Improvement Permit with plat valid without expiration. Improvement Permit with site plan valid for sixty months. Authorization to Construct is valid for a period equal to that of Improvement Permit – not to exceed sixty months.

Signed: Zeb Brawley date 4/2/04

Improvement Permit by: RS date 4/2/04

Authorization to Construct by: RS date 4/2/04

Installed by: Larry Beam

Operation Permit by: RS date 4/16/04

Existing System Inspection by: date

HEALTH DEPT. COPY: WHITE OWNER COPY (FINAL): YELLOW OWNER COPY (INITIAL): PINK