ICHD - ENVIRONMENTAL HEALTH DIVISION

Statesville Office (704) 878-5305 | ~~Mooresville Office (704) 660-3625~~ | PERMIT # AP 318541

SEPTIC: IMPROVEMENT PERMIT / AUTHORIZATION TO CONSTRUCT / OPERATION PERMIT / EXISTING SYSTEM

PIN # 4667 -- 93 -- 1151

APPLICANT/OWNER: Jeff Newman | APPLICANT ADDRESS: 138 Country Lake Dr Mooresville NC 28115

SITE ADDRESS: 225 Linwood Rd, Mooresville NC 28115 | PHONE: 704-677-2032 | ALT. PHONE

SITE DIRECTIONS: E Statesville Ave to R on N Main St, R on Linwood Rd, Lot on L

SUBDIVISION: | SECTION: — | LOT # — | LOT AREA: 0.37 acres | SAP CONTROLLED: [X] YES [ ] NO

DESIGN FLOW: Existing | L.T.A.R.: Existing

Septic Tank	1000 (gal)	STB Infiltrator	Date		
Pump Tank	— (gal)	PT —	Date —		
Pump Make	—	Model —	Serial # —		
# Nitrification Fields	5	# Lines 5	Linear Ft. 150		
Trench Width	36"	Trench Bottom Depth(Lowside)		Gravel Depth Existing	

[ ] New System [X] Repair [ ] Expansion System Type: I II III IV V VI

System Description:

Repair System Description: New tank

Maintenance Agreement Required: [ ] YES [X] NO

[X] GRAVITY [ ] PRESSURE

[X] Residence | No. Bedrooms Existing
[ ] Business | No. Persons Existing
[ ] Other | No. Employees
[ ] Slab | [X] Crawl Space
[ ] Basement w/plumbing | [ ] Basement w/o plumbing

Water Supply: [X] Private [ ] Public [ ] Community


Comments / Conditions: Pump, crush and Fill old ST. If tank is installed at 3' or deeper it must be traffic grade. No sign of system failure during inspection.

No foundation drains on back of house. Risers set, speed levelers set in new d-box

Old tank crushed & filled, trisher bar tank removed - all waste plumbed to new tank


INITIAL SITE SKETCH

1"=30'

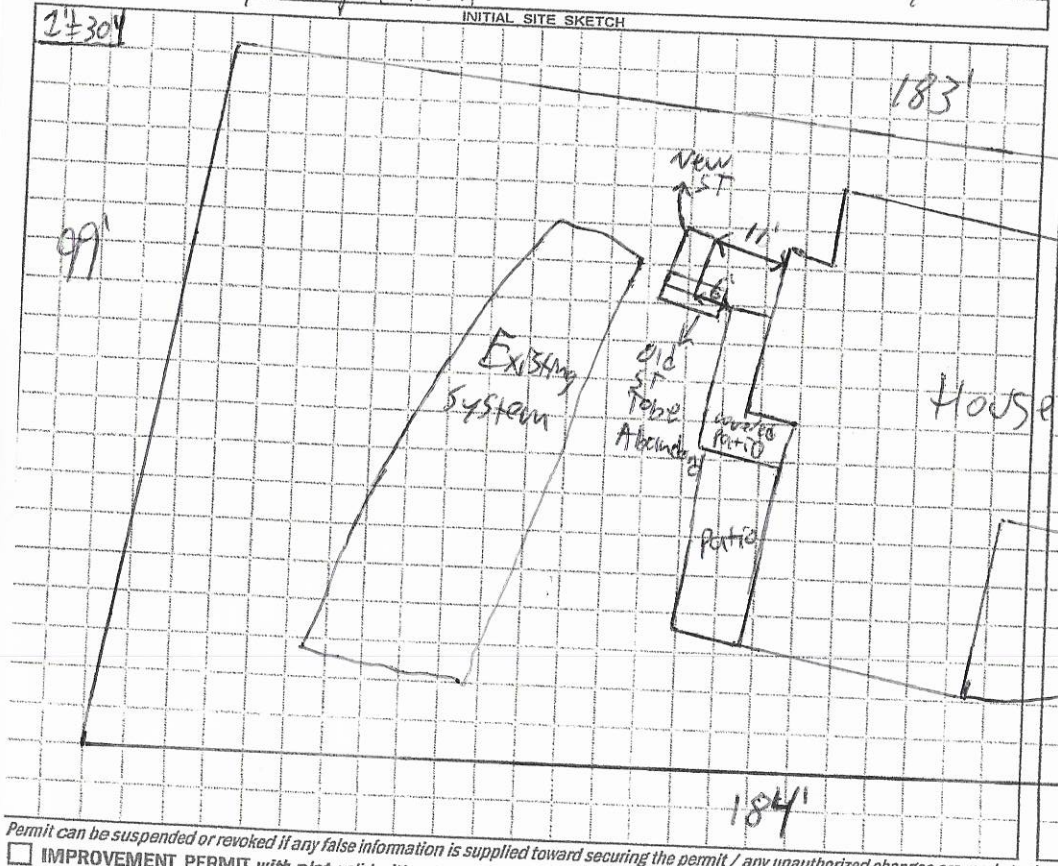

AS BUILT SKETCH

FOR SEPTIC FINAL INSPECTION CALL: 704-664-3703 between 8am-9am the day the inspection is needed. Be sure to speak with an inspector to confirm your time.

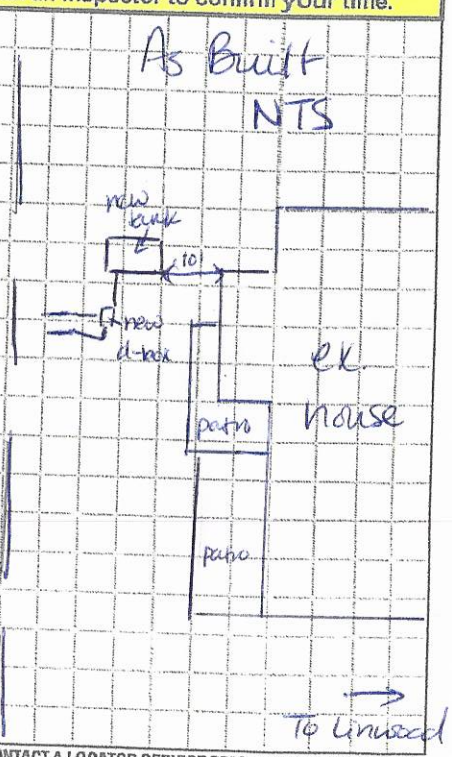

Permit can be suspended or revoked if any false information is supplied toward securing the permit / any unauthorized changes are made to the site / any unauthorized changes are made in the installation of the system. CONTACT A LOCATOR SERVICE PRIOR TO ANY EXCAVATION

[ ] IMPROVEMENT PERMIT *with plat valid without expiration.*

[X] IMPROVEMENT PERMIT *with site plan valid for 60 mos.*

[X] AUTHORIZATION TO CONSTRUCT *valid for period equal to IMPROVEMENT PERMIT--not to exceed 60 mo.*

Owner / Applicant Signature: Jeff Newman Date:

IMPROVEMENT PERMIT by: Patrick J Byle III Date: 6/10/2021

AUTHORIZATION TO CONSTRUCT by: Patrick J Byle III Date: 6/10/2021

Installed by: Joe Thompson (Wes) JST Enterprises

OPERATION PERMIT by: D Imeberg Date: 9/17/21

Existing System Inspected by: Date:

FOR SEPTIC FINAL INSPECTION: CALL 704-664-3703 between 8am-9am the day the inspection is needed

5/1234 to 1326

RECEIVED JUN C 8 2021

APPLICATION MUST BE FILLED OUT COMPLETELY & BE LEGIBLE OR IT WILL NOT BE PROCESSED

Iredell County Health Department – Environmental Health Division

PAGE 1: *APPLICATION FORM* AP-318541 $150.00

Application For:
( ) New Well Permit ( ) Well Repair Permit ( ) Well Abandonment
( ) Septic Improvement Permit ( ) Authorization to Construct ( ) Existing System Inspection (✓) Septic System Repair

THE ABOVE PERMIT DOCUMENTS WILL BECOME INVALID IF INFORMATION PROVIDED ON THIS APPLICATION IS FALSIFIED OR CHANGED, OR IF THE SITE IS ALTERED. THE IMPROVEMENT PERMIT IS VALID FOR EITHER 60 MONTHS OR WITHOUT EXPIRATION DEPENDING UPON DOCUMENTATION SUBMITTED. APPLICATION WITH SITE PLAN 60 MONTHS, APPLICATION WITH COMPLETE, SCALED PLAT WITHOUT EXPIRATION. SEE 15A NCAC 18A .1937(f) FOR DETAILS.

Page 2: *Site Plan Worksheet* form MUST accompany this application

The following optional attachments may also be submitted: ( ) Survey Plat, scaled no more than 1 inch = 60 feet
Place an (X) beside whichever is submitted if applicable ( ) Custom Site Plan, scaled no more than 1 inch = 60 feet

Applicant Information: (PRINT CLEARLY)

Applicant Name: Jeff Newman / Tonya Newman **Address:** 138 Country Lake Drive **Zip:** 28115
Applicant Email: JeffNewman1914@gmail.com **Phone:** 704-677-2032 **Alt. Phone:**
Owner Name: **Address:** **Zip:**
Owner Email: Call Wes Thompson **Phone:** 704 677 3320 **Alt. Phone:**

Property Information:

Street Address: 225 Linwood Rd Mooresville, NC 28115
Subdivision Name: **Section/Phase:** **Lot Number:**
Driving Directions: main Street to Linwood

Site Development Information: *(check or complete ALL that apply*

( ) New Single Family Residence
( ) New Multi-Family Residence
( ) Accessory Building
( ) Bedroom(s) Addition
(✓) Repair to failing septic system ___ Tank ___ Drain lines Describe Problem:
Maximum Number of Bedrooms: 3
Maximum Number of Occupants:
( ) Swimming Pool
( ) Other Addition/Structure:
Non-Residential Site Development: Type of Business:
Square Footage of Building: Max. Number of Employees: Max. Number of Seats/Beds/Other:

CHECK FOUNDATION TYPE
(✓) Crawl Space Foundation
( ) Concrete Slab Foundation
( ) Basement with Plumbing
( ) Basement without Plumbing

Water Supply: ( ) Replacement Well – Reason:
( ) Multi-connection Well Number of Houses: Number of Persons:
( ) New Well (✓) Existing Well ( ) Community Well ( ) City Water ( ) Other Public Water

Desired Septic System Type: *(you may rank in order of preference)* Year existing system installed:
( ) No Preference ( ) Alternative ( ) Conventional ( ) Innovative ( ) Modified Conventional ( ) Other:

Please answer the following to the best of your ability:
( ) Yes (✓) No Does the site contain any jurisdictional wetlands?
( ) Yes (✓) No Is any non-domestic sewage (i.e. industrial) to be generated?
( ) Yes (✓) No Is the site subject to approval by any other public agency?

I have read this application and certify that the information provided herein is true, complete, and correct. Authorized county and state officials are granted right of entry to conduct necessary inspections to determine compliance with applicable laws and rules. I understand that I am solely responsible for the proper identification and labeling of all property lines and corners and making the site accessible so that a complete site evaluation can be performed.

Signature: _____ 6/8/21
Property owner or owner's legal representative signature (SIGNATURE REQUIRED) DATE

IREDELL COUNTY DEPARTMENT OF ENVIRONMENTAL HEALTH

DOCUMENTATION TO AUTHORIZE AN OWNER'S LEGAL REPRESENTATIVE

(Check and sign only ONE of the options below)

☑ **1. * APPLICANT AND OWNER ARE THE SAME. *** (*Sign here*) Tonya Newm

Applications for permits require the "signature of the owner or owner's legal representative" (15A NCAC 18A .1937). If the owner does not sign the application himself or herself, they can submit any one of the following documents to designate their legal representative: *Power of Attorney; Real Estate Contract; Estate executor; Bankruptcy trustee; Court ordered guardianship* In the absence of the above documentation, the property owner may provide the local health department with documentation that designates a legal representative. A property owner may:
Complete this form to document his or her legal representative, or provide his or her own form that contains the information in this form. If there are multiple property owners, then all property owners must sign the form that designates a legal representative.

By signing a form that designates a legal representative for purposes of 15A NCAC 18A .1937, the property owner authorizes that representative to act on their behalf in matters pertaining to the application and permitting process, including signing or receiving any application, document or permit. The owner retains full responsibility to meet all permit conditions specified by the local health department.

☐ **2.** I, Tonya Newm, am the legal owner(s) of the property located at 225 Linwood rd, identified as PIN (Parcel Identification Number)_____, located in Iredell County, North Carolina.

I do hereby authorize (**print legal representative/company name**) Wess Thompson 704-677-3320 _____, to act as an agent on my behalf in applying for/signing/obtaining any of the documents described below.

- Application for Improvement Permit (IP) / Authorization to Construct (AC)
- Improvement Permit (IP) / Authorization to Construct (AC)
- Application for soil-site evaluation (new/repair)
- Application/permit for private drinking water well/well abandonment
- Application for Compliance Inspection

I agree to abide by all decisions and/or conditions between the legal representative acting on my behalf and the Iredell County Department of Public Health, Environmental Health Division.

Tonya Newm
Signature of Owner(s)

6/8/21
Date

Mooresville - Environmental Health

Fax: 704-662-3239
610 E. Center Avenue, Mooresville, NC 28115


Statesville - Environmental Health
ronda.hart@co.iredell.nc.us
Fax: 704-871-3483
349 N. Center Street, Statesville, NC 28677

IREDELL COUNTY HEALTH DEPARTMENT

ENVIRONMENTAL HEALTH DIVISION

PAGE 2: ***SITE PLAN WORKSHEET***

SEE THE "SAMPLE SITE PLAN" BELOW. ***INCOMPLETE SITE PLANS WILL BE RETURNED TO YOU FOR COMPLETION AND MAY RESULT IN A DELAY IN THE ISSUANCE OF YOUR SEPTIC SYSTEM PERMIT!!!***

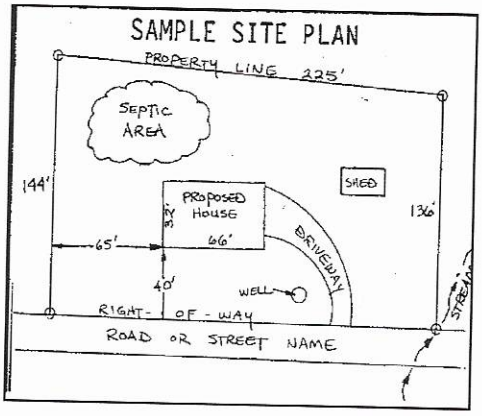

Place an (X) beside each item as you complete the site plan:


( ) Property Line measurements are clearly identified
( ) All proposed structures are indicated
( ) Front and side setbacks from property line
( ) Preferred driveway location and well location
( ) Area you prefer your septic system to be placed
( ) North arrow, or other sufficient indicator of direction

Circle N/A on the following if appropriate:

Location of septic systems and wells within 100' of your property	N/A
Location of easements and rights of ways on your property	N/A
Location of any designated wetlands on the property	N/A

USE THIS SPACE TO DRAW YOUR SITE PLAN

Show: proposed house or business footprint, wells, water lines, patios, pools and decks, and any other item that will occupy space on the site

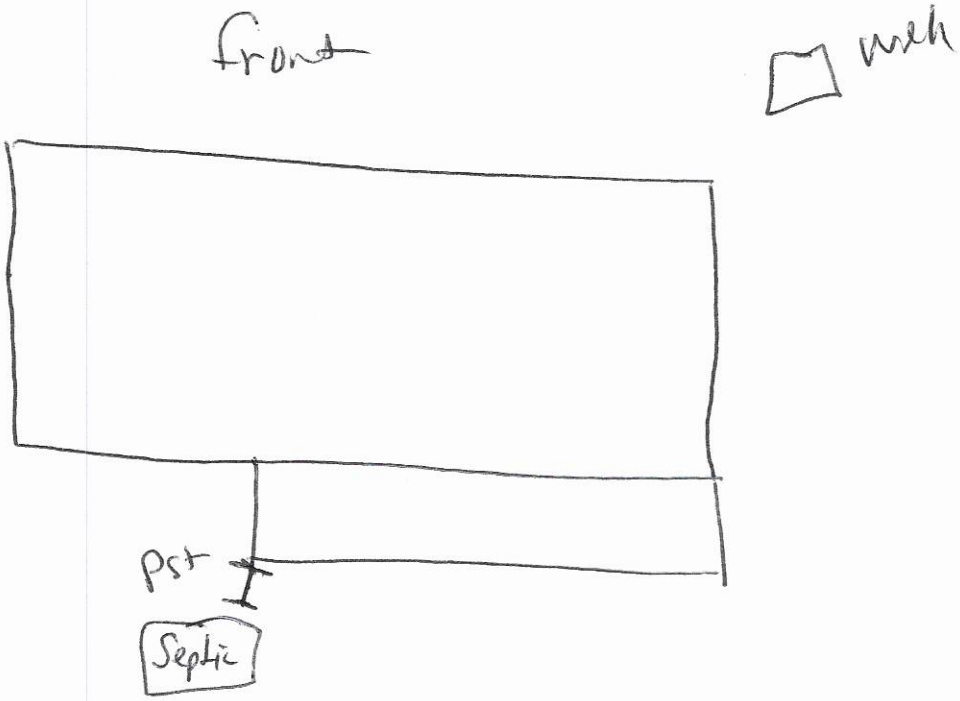

Signature: _____

Property owner or owner's legal representative signature (SIGNATURE REQUIRED)

6/8/21

DATE