IREDELL COUNTY HEALTH DEPARTMENT

STATESVILLE 704-878-5305 MOORESVILLE 704-664-5281

IMPROVEMENT PERMIT / AUTHORIZATION TO CONSTRUCT / OPERATION PERMIT / EXISTING SYSTEM INSPECTION

PERMIT# Repair PIN# 4606796 5084 DATE

OWNER OR CONTRACTOR Grant Moon PHONE: Business Home 704-662-9498

ADDRESS 1463 N. Main St Mooresville NC 28115

LOCATION N. Main St on Rt 9th past Tarheel Electric #1463

SUBDIVISION None BLOCK / SECTION LOT LOT AREA SITE CLASS. PS DESIGN FLOW 240 L.T.A.R. —

Septic Tank: ~~Existing~~ Gallons; STB 312 Date 2/19/03

Pump Tank: Gallons; PT Date

Pump Make: Model Serial No.

Nitrification Field: No Fields Square Feet 720 Linear Feet 240

No Lines 3 @ 80' Trench Width 36" Max Trench Bottom Depth Gravel Depth —

☐ New System ☒ Repair System Type: I, II, (III), IV, V, VI

System Description:

Repair System Description: Gravity 25% Reduction

Maintenance Agreement Required: ☐ Yes ☒ No

☒ House/Mod. Home No. Bedrooms 3

☐ Mobile Home No. Bathrooms 1

☐ Business No. Employees

☐ Other

☐ Slab ☒ Crawl Space ☐ Basement w/plumbing ☐ Basement wo/plumbing

Water Supply: ☒ Individual ☐ Public ☐ Community Exist.


Comments:/Conditions:

* - 18" of Separation Between Water Line & Sewer line


Comments:/Conditions:

4/22/03 - Plumbing to be shallowed up and down 1000 ST installed EZ FLOW INSTALLED

INITIAL SITE SKETCH

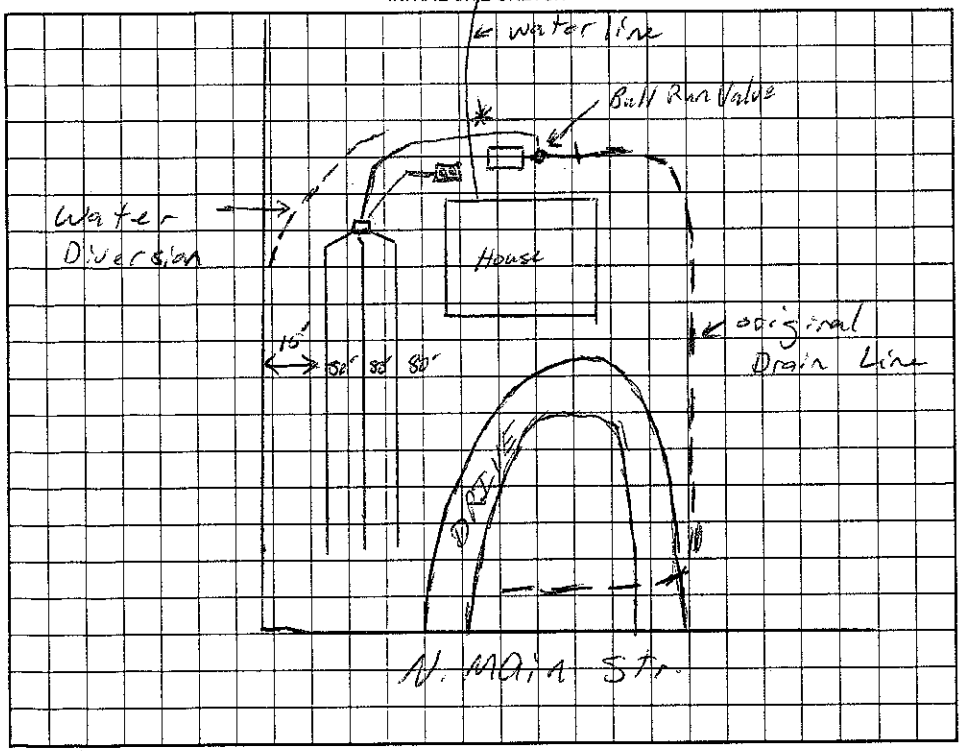

AS BUILT SKETCH

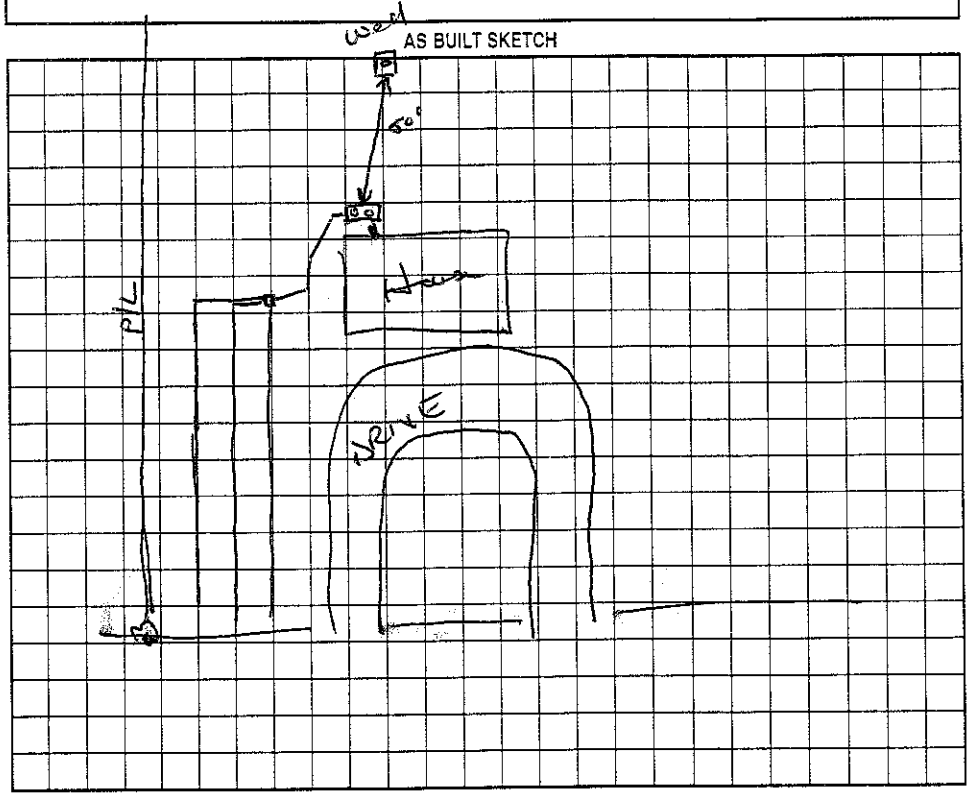

Permit can be suspended or revoked if any false information is supplied toward securing the permit/any unauthorized changes are made to the site/any unauthorized changes are made in the installation of the system. Improvement Permit with plat valid without expiration. Improvement Permit with site plan valid for sixty months. Authorization to Construct is valid for a period equal to that of Improvement Permit – not to exceed sixty months.

Signed: Grant Moon date 3-18-03

Improvement Permit by: RS date 3/18/03

Authorization to Construct by: RS date 3/18/03

Installed by: Lavon Benton

Operation Permit by: Wesley Sparks RS date 4/22/03

Existing System Inspection by: date

HEALTH DEPT. COPY: WHITE OWNER COPY (FINAL): YELLOW OWNER COPY (INITIAL): PINK