4668060937

IREDELL COUNTY HEALTH DEPARTMENT

STATESVILLE 704-878-5305 MOORESVILLE 704-664-5281

IMPROVEMENT PERMIT / CERTIFICATE OF COMPLETION / OPERATION PERMIT / EXISTING SYSTEM INSPECTION

PROPERTY DESCRIPTION NO. 20705 DATE 6/2/95 TAX MAP NO. 1M - A - 139 Watershed: ☐ Yes ☒ No

OWNER OR CONTRACTOR Doris Brown PHONE: Business 528-4516 Home

ADDRESS PO Box 751 Huntersville, NC. 28078

LOCATION Shinnville off 115 N TR on Little Creek Rd. TL to 4th lot on (L)

SUBDIVISION BLOCK / SECTION LOT #4 LOT AREA ~1.65 AC SITE CLASS. P DESIGN FLOW 360 L.T.A.R. .4

Septic Tank: 1000 Gallons; STB 1012 Date 3/7/95
Pump Tank: Gallons; PT Date
Pump Make: Model Serial No.
Nitrification Field: No Fields 1 Square Feet 1200 Linear Feet 400
No Lines 4 Trench Width 36" Max Trench Bottom Depth 36" Gravel Depth

☒ New System ☐ Repair System Type: I (II) III, IV, V, VI
System Description: CONV - DIST BOX
Repair System Description: SAME
Maintenance Agreement Required: ☐ Yes ☒ No


☒ House/Mod. Home No. Bedrooms 3
☐ Mobile Home No. Bathrooms 2
☐ Business No. Employees
☐ Other
☐ Slab ☒ Crawl Space ☐ Basement w/plumbing ☐ Basement wo/plumbing

Water Supply: ☒ Individual ☐ Community ☐ Public


Comments: Lines to follow contours closely. Maximum depth no greater than 36" to trench bottom.

Comments: LAYOUT MIRRORED AT OWNERS REQUEST.

INITIAL SITE SKETCH

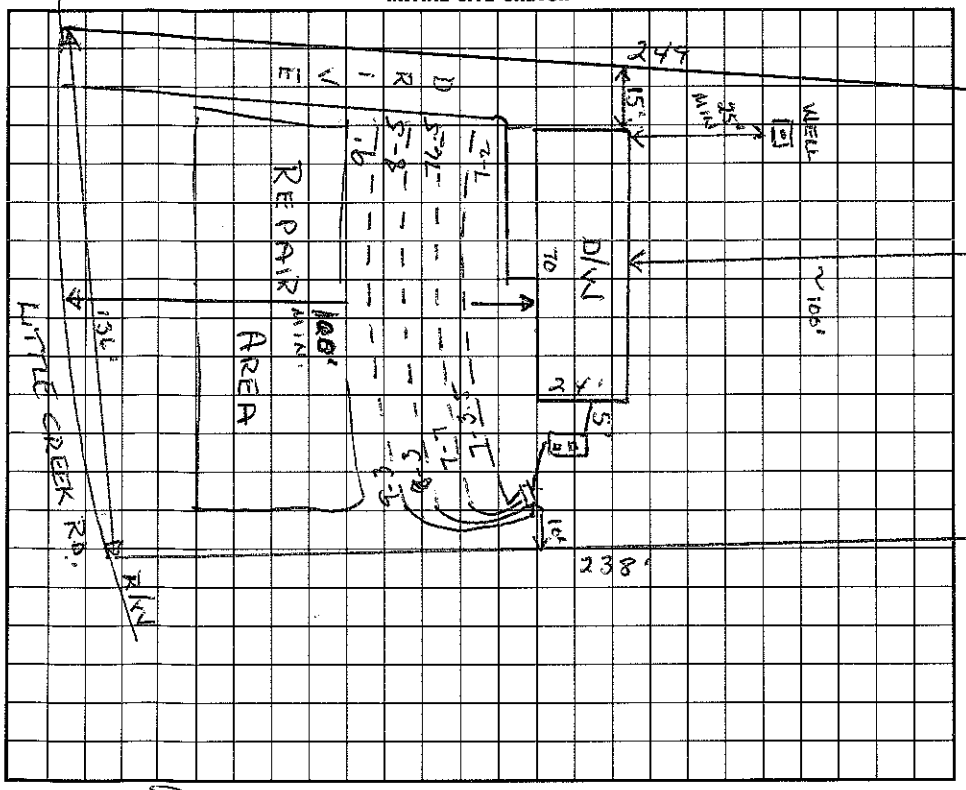

AS BUILT SKETCH

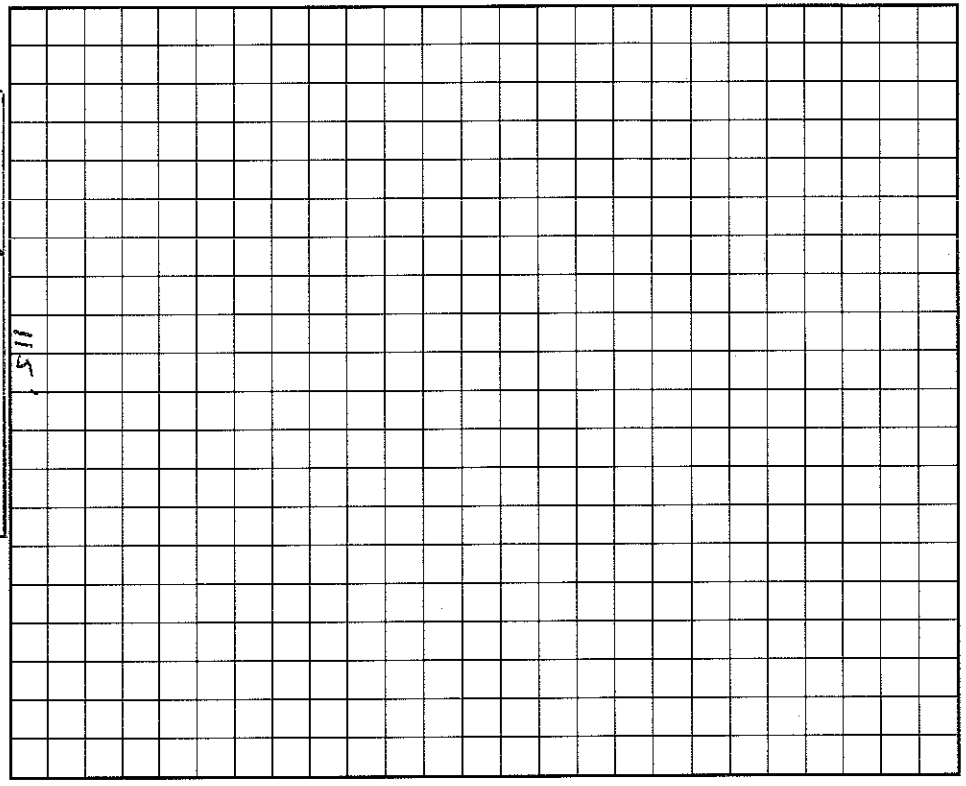

I understand that this permit can be suspended or revoked if any false information is supplied toward securing the permit/any unauthorized changes are made to the site/any unauthorized changes are made in the installation of the system. Improvement Permit is valid for 60 months from date of issuance.

Signed:

Improvement Permit by: Wesley Sparks R.S. date 6/2/95

Existing System Inspection by: date

Installed by: Kenny Pearson

Certificate of Completion by: Wesley Sparks R.S. date 6/9/95

Operation Permit by: date

HEALTH DEPT. COPY: WHITE INSPECTION COPY (FINAL): GREEN OWNER COPY (FINAL): YELLOW INSPECTION COPY (INITIAL): PINK OWNER COPY (INITIAL): GOLD