ICHD - ENVIRONMENTAL HEALTH DIVISION

Statesville Office (704) 878-5305 | Mooresville Office (704) 660-3625 | PERMIT # AP 319313

SEPTIC: IMPROVEMENT PERMIT / AUTHORIZATION TO CONSTRUCT / OPERATION PERMIT / EXISTING SYSTEM

PIN # 4668-06-1706

APPLICANT/OWNER: Tim Aaron Ammons | APPLICANT ADDRESS: 215 Little Creek Rd Mooresville NC 28115

SITE ADDRESS: 225 Little Creek Rd Mooresville NC 28115 | PHONE: 248-205-6519 | ALT. PHONE 704-663-7631

SITE DIRECTIONS: NC 115 N to R on Shinnville Rd, R on Little creek Rd, Lot at end | SAP CONTROLLED: [ ] YES [X] NO

SUBDIVISION: — | SECTION: — | LOT # — | LOT AREA: 0.98 acres | DESIGN FLOW: Existing | L.T.A.R.: Existing

Septic Tank 1000 (gal) STB Infiltrator Date —
Pump Tank — (gal) PT — Date —
Pump Make — Model — Serial # —
Nitrification Fields — # Lines — Linear Ft —
Trench Width EXISTING | Trench Bottom Depth(Low side) — | Gravel Depth Existing


[ ] New System [X] Repair [ ] Expansion System Type: I (II) III IV V VI
System Description: New Tank
Repair System Description: Existing
Maintenance Agreement Required: [ ] YES [X] NO
[X] GRAVITY [ ] PRESSURE

[X] Residence No. Bedrooms Existing
[ ] Business No. Persons Existing
[ ] Other No. Employees —
[ ] Slab [X] Crawl Space
[ ] Basement w/plumbing [ ] Basement w/o plumbing

Water Supply: [X] Private [ ] Public [ ] Community


Comments / Conditions: Pump, crush and Remove old ST. If tank is installed at 3' or deeper it must be traffic grade. Property lines, corners and house box MUST be clearly marked during time of Installation and inspection. Any part of septic must be 5' off foundation of house

INITIAL SITE SKETCH

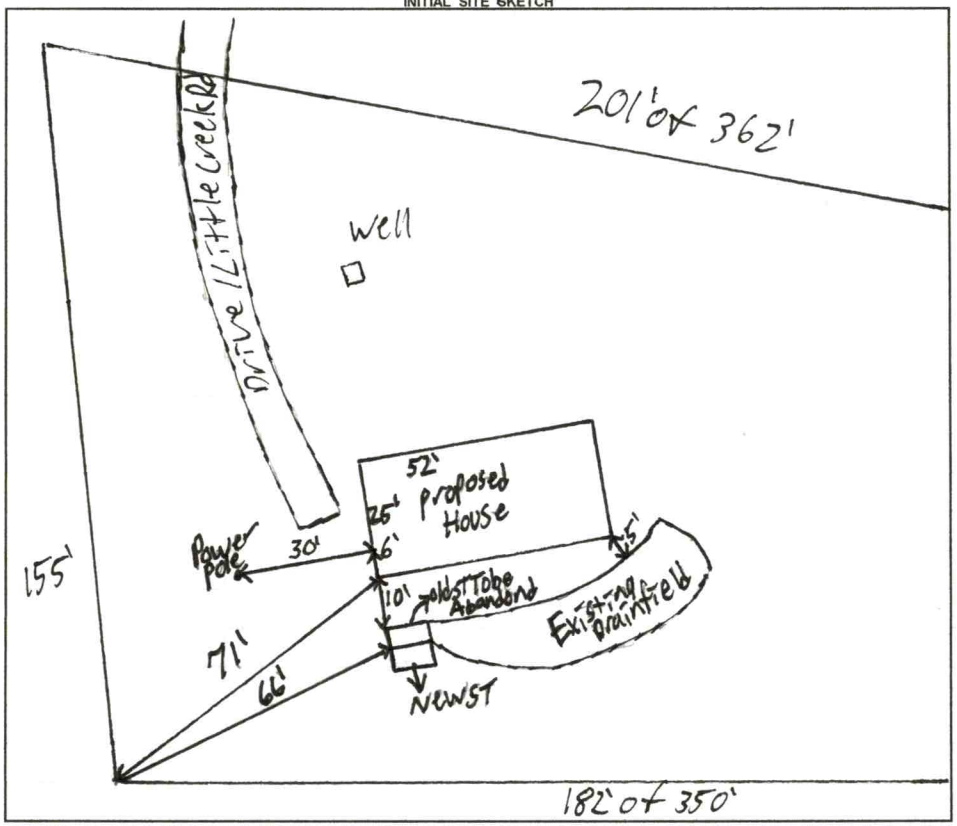

AS BUILT SKETCH

FOR SEPTIC FINAL INSPECTION CALL: 704-664-3703 between 8am-9am the day the inspection is needed. Be sure to speak with an inspector to confirm your time.

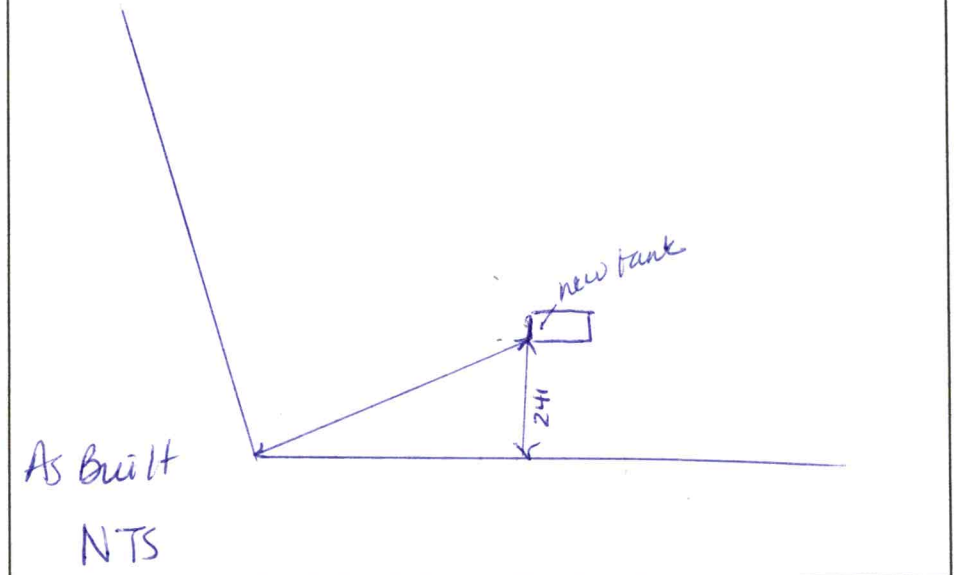

Permit can be suspended or revoked if any false information is supplied toward securing the permit / any unauthorized changes are made to the site / any unauthorized changes are made in the installation of the system. **CONTACT A LOCATOR SERVICE PRIOR TO ANY EXCEPTION**

[ ] **IMPROVEMENT PERMIT** *with plat valid without expiration.* [X] **IMPROVEMENT PERMIT** *with site plan valid for 60 mos.* [X] **AUTHORIZATION TO CONSTRUCT** *valid for period equal to IMPROVEMENT PERMIT--not to exceed 60 mo.*

Owner / Applicant Signature: Amanda Stockwell | Date: 7/9/2021 | Installed by: TW Ammons

IMPROVEMENT PERMIT by: Patrick J Boyle III | Date: 7/8/2021 | OPERATION PERMIT by: D. Wiebert | Date: 8/11/21

AUTHORIZATION TO CONSTRUCT by: Patrick J Boyle III | Date: 7/8/2021 | Existing System Inspected by: — | Date: —

FOR SEPTIC FINAL INSPECTION: CALL 704-664-3703 between 8am-9am the day the inspection is needed.

Item	Date	Initials
Drain Lines Checked		
Tanks Checked		
Pressure Manifold or Valve Box Checked		
Pressure Head Set		
Electrical Checked		
Floats Set		
Alarm Checked		
Maintenance Contract Needed? Y / N		
Comments:		


Repairs Only	
	State Code
Failing System Code	
Type of Distribution	G or P
Type of Failure/Malfunction	
Primary Cause of Failure/Malfunction	
Age of System? _____	
Initial or Repair? _____	

CONNECTGIS WEB HOSTING

North Carolina Iredell County

1:41

Search

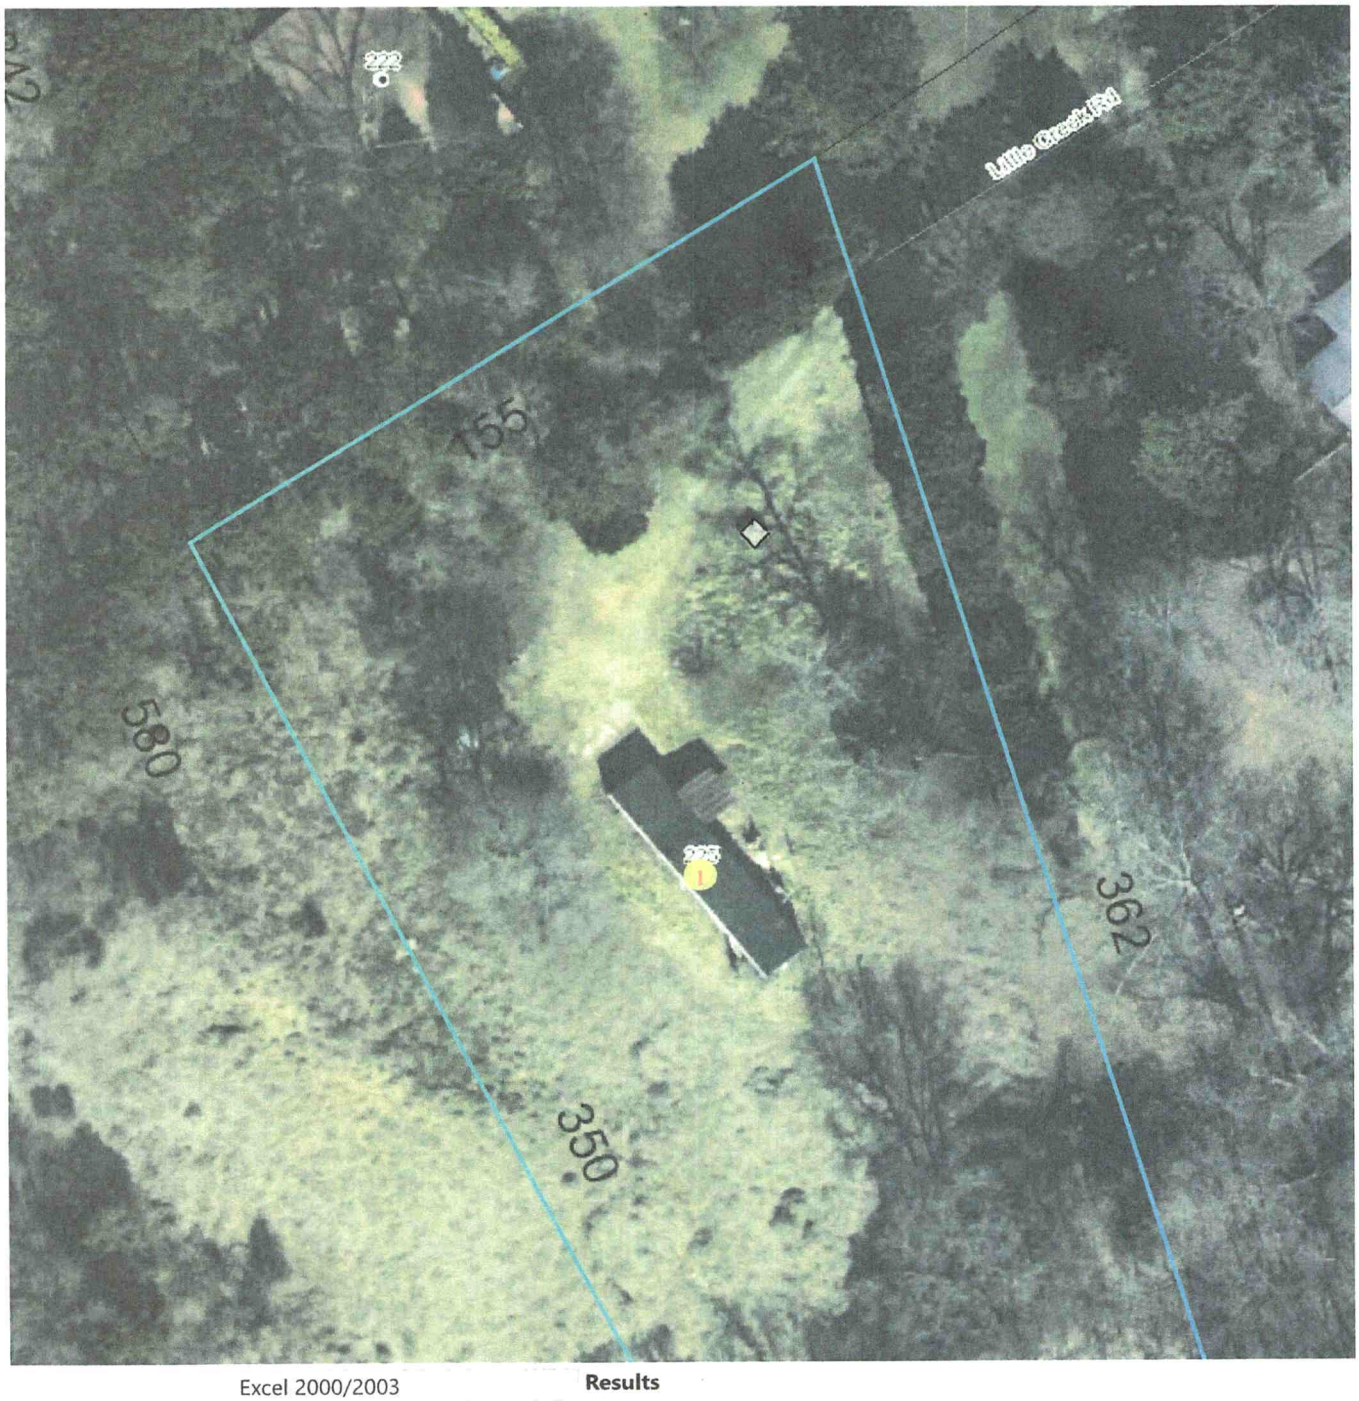

Excel 2000/2003 **Results**

©2009-2021 Dude Solutions. All Rights Reserved. | Soft

RECEIVED JUN 3 0 2021

APPLICATION MUST BE FILLED OUT COMPLETELY & BE LEGIBLE OR IT WILL NOT BE PROCESSED

Iredell County Health Department – Environmental Health Division

PAGE 1: *APPLICATION FORM* AP-319313 Repair ERef

Application For: ( ) New Well Permit ( ) Well Repair Permit ( ) Well Abandonment
( ) Septic Improvement Permit ( ) Authorization to Construct ( ) Existing System Inspection (✓) Septic System Repair

THE ABOVE PERMIT DOCUMENTS WILL BECOME INVALID IF INFORMATION PROVIDED ON THIS APPLICATION IS FALSIFIED OR CHANGED, OR IF THE SITE IS ALTERED. THE IMPROVEMENT PERMIT IS VALID FOR EITHER 60 MONTHS OR WITHOUT EXPIRATION DEPENDING UPON DOCUMENTATION SUBMITTED. APPLICATION WITH SITE PLAN 60 MONTHS, APPLICATION WITH COMPLETE, SCALED PLAT WITHOUT EXPIRATION. SEE 15A NCAC 18A .1937(f) FOR DETAILS.

Page 2: *Site Plan Worksheet* form MUST accompany this application

The following optional attachments may also be submitted: ( ) Survey Plat, scaled no more than 1 inch = 60 feet
Place an (X) beside whichever is submitted if applicable ( ) Custom Site Plan, scaled no more than 1 inch = 60 feet

Applicant Information: (PRINT CLEARLY)

Applicant Name: TIMOTHY AARON AMMONS Address: 215 LITTLE CREEK RD Zip: 28115
Applicant Email: BIGNEWSPAPER@GMAIL.COM Phone: 248-205-6519 Alt. Phone: 704-663-7631
Owner Name: TIMOTHY AARON AMMONS Address: 215 LITTLE CREEK RD Zip: 28115
Owner Email: BIGNEWSPAPER@GMAIL.COM Phone: 248-205-6519 Alt. Phone: 248-2298056

Property Information:

Street Address: 225 LITTLE CREEK RD, MOORESVILLE, NC 28115

Subdivision Name: — Section/Phase: — Lot Number: —

Driving Directions: 42 exit SOUTH LEFT onto SHINNVILLE Road, RIGHT onto Little CREEK

Site Development Information: *(check or complete ALL that apply*

CHECK FOUNDATION TYPE

(X) New Single Family Residence — Maximum Number of Bedrooms: 3 — (X) Crawl Space Foundation
( ) New Multi-Family Residence — Maximum Number of Occupants: 4 — ( ) Concrete Slab Foundation
( ) Accessory Building — ( ) Swimming Pool — ( ) Basement with Plumbing
(X) Bedroom(s) Addition — ( ) Other Addition/Structure: _____ — ( ) Basement without Plumbing
(X) Repair to failing septic system X Tank ___ Drain lines Describe Problem: EXISTING SEPTIC TANK CAVED IN
Non-Residential Site Development: Type of Business: _____
Square Footage of Building: _____ Max. Number of Employees: ____ Max. Number of Seats/Beds/Other: ____

Water Supply: ( ) Replacement Well – Reason: _____
( ) Multi-connection Well Number of Houses: _____ Number of Persons: _____

( ) New Well (X) Existing Well ( ) Community Well ( ) City Water ( ) Other Public Water


Desired Septic System Type: *(you may rank in order of preference)* Year existing system installed: 1984
( ) No Preference ( ) Alternative ( ) Conventional ( ) Innovative ( ) Modified Conventional ( ) Other: _____

Please answer the following to the best of your ability:

( ) Yes (X) No Does the site contain any jurisdictional wetlands?
( ) Yes (X) No Is any non-domestic sewage (i.e. industrial) to be generated?
( ) Yes (X) No Is the site subject to approval by any other public agency?

I have read this application and certify that the information provided herein is true, complete, and correct. Authorized county and state officials are granted right of entry to conduct necessary inspections to determine compliance with applicable laws and rules. I understand that I am solely responsible for the proper identification and labeling of all property lines and corners and making the site accessible so that a complete site evaluation can be performed.

Signature: _____ 06/28/2021
Property owner or owner's legal representative signature (SIGNATURE REQUIRED) DATE

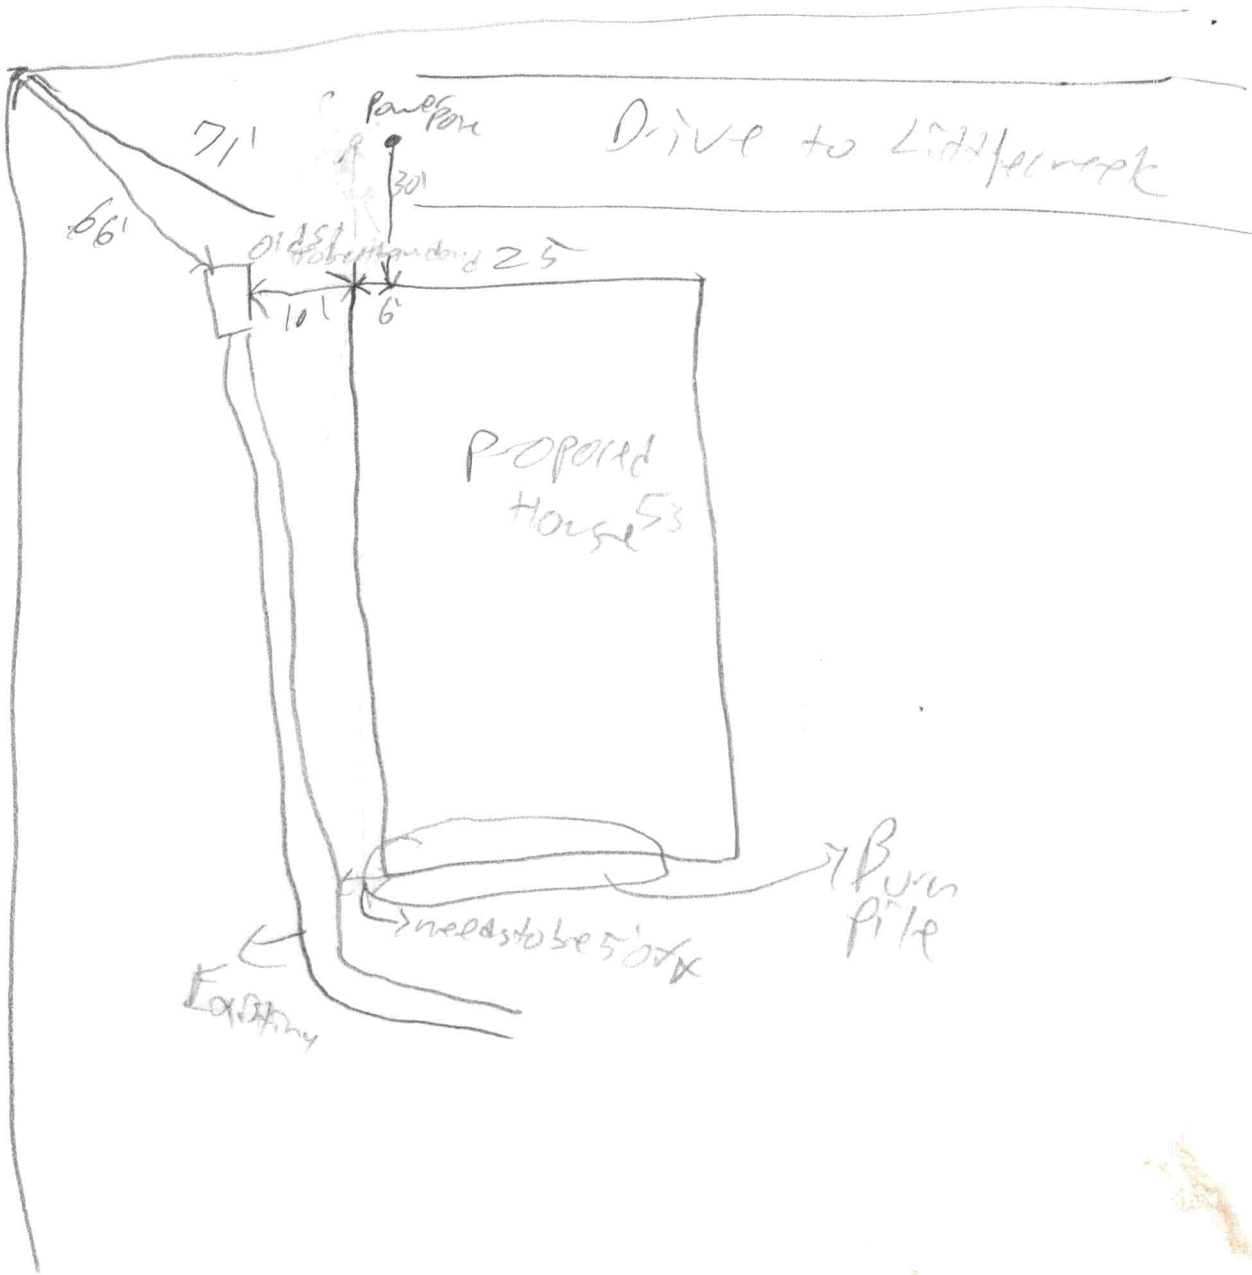

71'
Power Pole
30'
66'
10'
6'
25'
Proposed House 53
Burn Pile
needs to be 5' or x
Existing

IREDELL COUNTY HEALTH DEPARTMENT

ENVIRONMENTAL HEALTH DIVISION

PAGE 2: *SITE PLAN WORKSHEET*

SEE THE "SAMPLE SITE PLAN" BELOW. *INCOMPLETE SITE PLANS WILL BE RETURNED TO YOU FOR COMPLETION AND MAY RESULT IN A DELAY IN THE ISSUANCE OF YOUR SEPTIC SYSTEM PERMIT!!!*

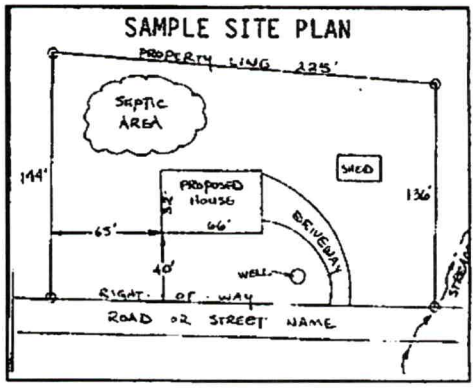

Place an (X) beside each item as you complete the site plan:


- (X) Property Line measurements are clearly identified
- (X) All proposed structures are indicated
- (X) Front and side setbacks from property line
- (X) Preferred driveway location and well location
- (X) Area you prefer your septic system to be placed
- (X) North arrow, or other sufficient indicator of direction

Circle N/A on the following if appropriate:

Location of septic systems and wells within 100' of your property	N/A
Location of easements and rights of ways on your property	N/A
Location of any designated wetlands on the property	N/A

USE THIS SPACE TO DRAW YOUR SITE PLAN

Show: proposed house or business footprint, wells, water lines, patios, pools and decks, and any other item that will occupy space on the site

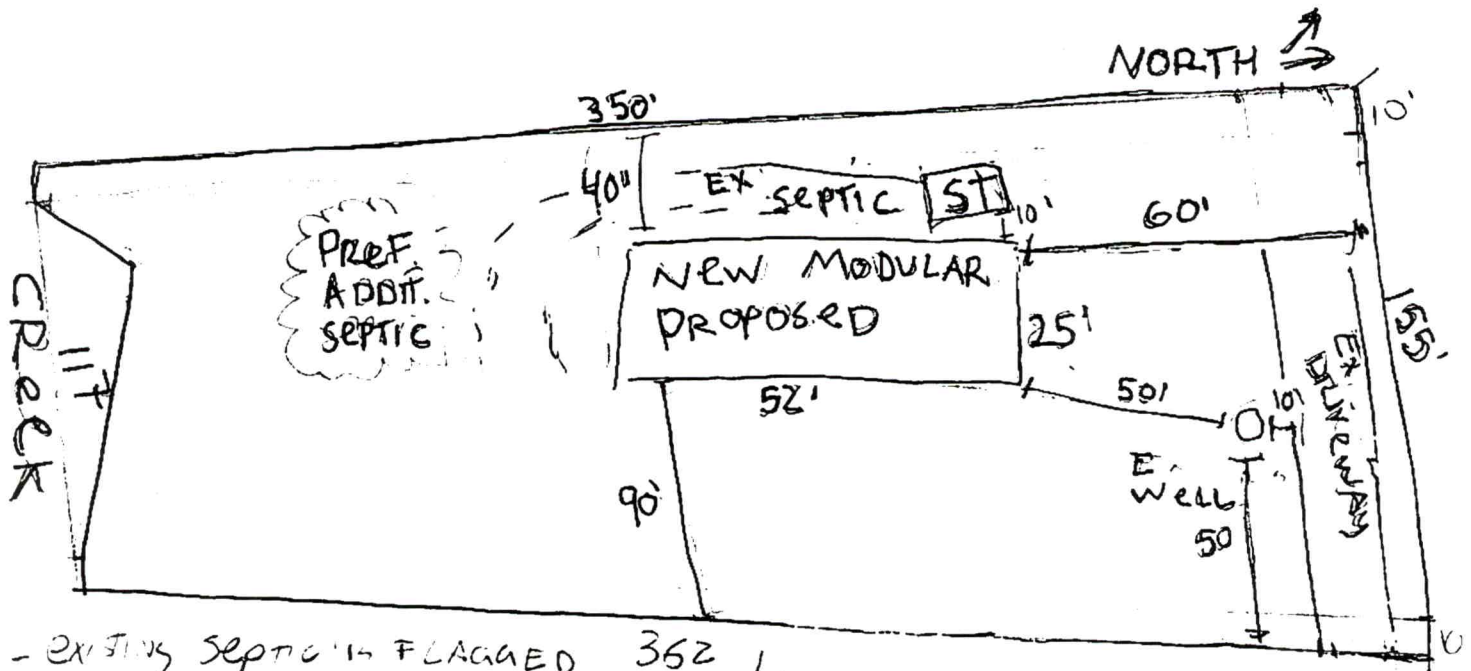

- EXISTING SEPTIC IS FLAGGED 362
- PROPOSED HOMESITE IS FLAGGED
- PROPERTY LINES ARE VISIBLE
- ATTACHED EXISTING SEPTIC PERMIT

- WELL TO PROPOSED HOUSE CORNER 50'
- PROPOSED HOUSE TO N PROPERTY 60'
- PROPOSED HOUSE TO W PROPERTY 40'
- EX ST IS 10' FROM PROPOSED HOUSE
- WELL IS 50' OFF E PROPERTY
- WELL IS 10' EX. DRIVEWAY

Signature: _____ 06/28/202

Property owner or owner's legal representative signature (SIGNATURE REQUIRED) — DATE

IREDELL COUNTY DEPARTMENT OF ENVIRONMENTAL HEALTH

DOCUMENTATION TO AUTHORIZE AN OWNER'S LEGAL REPRESENTATIVE

(Check and sign only ONE of the options below)

☒ **1. * APPLICANT AND OWNER ARE THE SAME. *** (*Sign here*) _____

Applications for permits require the "signature of the owner or owner's legal representative" (15A NCAC 18A .1937). If the owner does not sign the application himself or herself, they can submit any one of the following documents to designate their legal representative: *Power of Attorney; Real Estate Contract; Estate executor; Bankruptcy trustee; Court ordered guardianship* In the absence of the above documentation, the property owner may provide the local health department with documentation that designates a legal representative. A property owner may:
Complete this form to document his or her legal representative, or provide his or her own form that contains the information in this form. If there are multiple property owners, then all property owners must sign the form that designates a legal representative.
By signing a form that designates a legal representative for purposes of 15A NCAC 18A .1937, the property owner authorizes that representative to act on their behalf in matters pertaining to the application and permitting process, including signing or receiving any application, document or permit. The owner retains full responsibility to meet all permit conditions specified by the local health department.

☐ **2.** I, _____, am the legal owner(s) of the property located at _____, identified as PIN (Parcel Identification Number)_____, located in Iredell County, North Carolina.

I do hereby authorize (**print legal representative/company name**) Amanda Gadwell _____, to act as an agent on my behalf in applying for/signing/obtaining any of the documents described below.

- Application for Improvement Permit (IP) / Authorization to Construct (AC)
- Improvement Permit (IP) / Authorization to Construct (AC)
- Application for soil-site evaluation (new/repair)
- Application/permit for private drinking water well/well abandonment
- Application for Compliance Inspection

I agree to abide by all decisions and/or conditions between the legal representative acting on my behalf and the Iredell County Department of Public Health, Environmental Health Division.

_____ 06/28/2021
Signature of Owner(s) Date

Mooresville - Environmental Health
Fax: 704-662-3239
610 E. Center Avenue, Mooresville, NC 28115

Statesville - Environmental Health
ronda.hart@co.iredell.nc.us
Fax: 704-871-3483
349 N. Center Street, Statesville, NC 28677