4668 0815 pt 2

IREDELL COUNTY HEALTH DEPARTMENT

STATESVILLE 704-878-5305 MOORESVILLE 704-664-5281

IMPROVEMENT PERMIT / CERTIFICATE OF COMPLETION / OPERATION PERMIT / EXISTING SYSTEM INSPECTION

PROPERTY DESCRIPTION NO. 18802 DATE 8/16/94 TAX MAP NO. IM-A-7 Watershed: ☑ Yes ☐ No

OWNER OR CONTRACTOR Sarah D. Henderson PHONE: Business _____ Home 663-3561

ADDRESS 357 Meagepa Rd.

LOCATION Shinnville Rd, on (R) across from bet #225

SUBDIVISION No BLOCK / SECTION _____ LOT _____ LOT AREA ~ 40,000 FT² SITE CLASS. P DESIGN FLOW 240 L.T.A.R. .3

Septic Tank: 1250 Gallons; STB 994 Date _____

Pump Tank: _____ Gallons; PT _____ Date _____

Pump Make: _____ Model _____ Serial No. _____

Nitrification Field: No Fields 1 Square Feet 800 Linear Feet 266

No Lines 3 Trench Width 36" Max Trench Bottom Depth 30-32" Gravel Depth _____

☑ New System ☐ Repair System Type: I, ☑ III, IV, V, VI

System Description: CONV - DIST BOX

Repair System Description: _____

Maintenance Agreement Required: ☐ Yes ☐ No

☑ House/Mod. Home No. Bedrooms 2

☐ Mobile Home No. Bathrooms 2

☐ Business No. Employees _____

☑ Other GAR. DISP.


☐ Slab ☑ Crawl Space ☐ Basement w/plumbing ☐ Basement wo/plumbing

Water Supply: ☑ Individual ☐ Community ☐ Public

Comments: SET PLUMBING AND SEPTIC TANK SHALLOW - GOING SLIGHTLY AGAINST GRADE / MAX TRENCH DEPTH 32" 1250 S/T DUE TO GARBAGE DISPOSAL

Comments: installed as shown on Imp. Permit

INITIAL SITE SKETCH

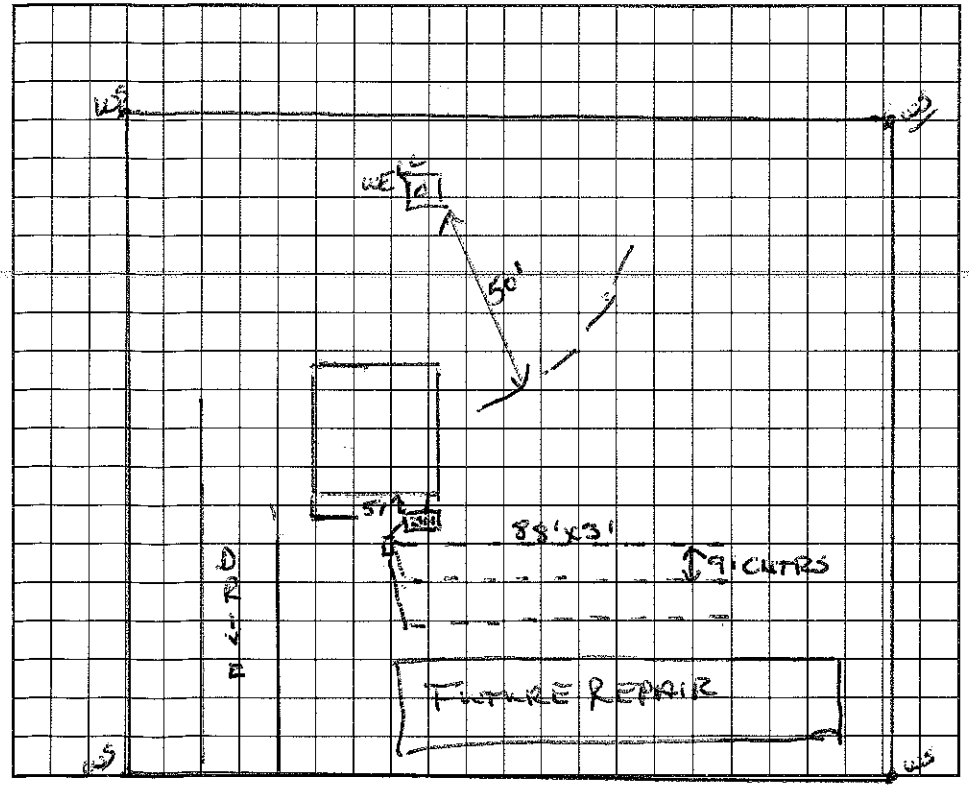

AS BUILT SKETCH

I understand that this permit can be suspended or revoked if any false information is supplied toward securing the permit/any unauthorized changes are made to the site/any unauthorized changes are made in the installation of the system. Improvement Permit is valid for 60 months from date of issuance. SHINNVILLE RD

Signed: Sarah D. Henderson

Improvement Permit by: Wesley Sparks RS. date 8/16/94

Existing System Inspection by: _____ date _____

Installed by: Wayne Osborne

Certificate of Completion by: Wesley Sparks RS. date 12/2/94

Operation Permit by: _____ date _____

HEALTH DEPT. COPY: WHITE INSPECTION COPY (FINAL): GREEN OWNER COPY (FINAL): YELLOW INSPECTION COPY (INITIAL): PINK OWNER COPY (INITIAL): GOLD