IREDELL COUNTY HEALTH DEPARTMENT

STATESVILLE 704-878-5305 MOORESVILLE 704-664-5281

Paid 175.00 10-20-00 3:30

IMPROVEMENT PERMIT / AUTHORIZATION TO CONSTRUCT / OPERATION PERMIT / EXISTING SYSTEM INSPECTION

PERMIT# 090928 PIN# ~~4658995249 (pt)~~ 4668-09-0193 DATE October 19, 00

OWNER OR CONTRACTOR Mid Carolina Dev. PHONE: Business 634-0173 Home

ADDRESS P.O. Box 1580 Carrollus 28031

LOCATION 115 N TR Shiloville Rd. TL Carolina Wren Drive 2nd lot on left

SUBDIVISION Grace Meadows BLOCK / SECTION LOT 31 LOT AREA .49ac SITE CLASS. PS DESIGN FLOW 360gpd L.T.A.R. .37

Septic Tank: 1000 Gallons; STB 1012 Date 9/18/01

Pump Tank: Gallons; PT Date

Pump Make: Model Serial No.

Nitrification Field: No Fields 1 Square Feet 900 Linear Feet 300

No Lines 4 Trench Width 36" Max Trench Bottom Depth 36"

☑ New System ☐ Repair System Type: I, II, (III), IV, V, VI

System Description: Gravity Innovative -25% Reduction

Repair System Description: Pm/LP Panel Block

Maintenance Agreement Required: ☐ Yes ☑ No

Gravel Depth N/A

☑ House/Mod. Home ☐ Mobile Home ☐ Business ☐ Other

No. Bedrooms 3 No. Bathrooms 2 No. Employees

☐ Slab ☑ Crawl Space ☐ Basement w/plumbing ☐ Basement wo/plumbing


Water Supply: ☑ Individual ☐ Public ☐ Community

Comments:/Conditions:

Comments:/Conditions:

1"=50'

INITIAL SITE SKETCH

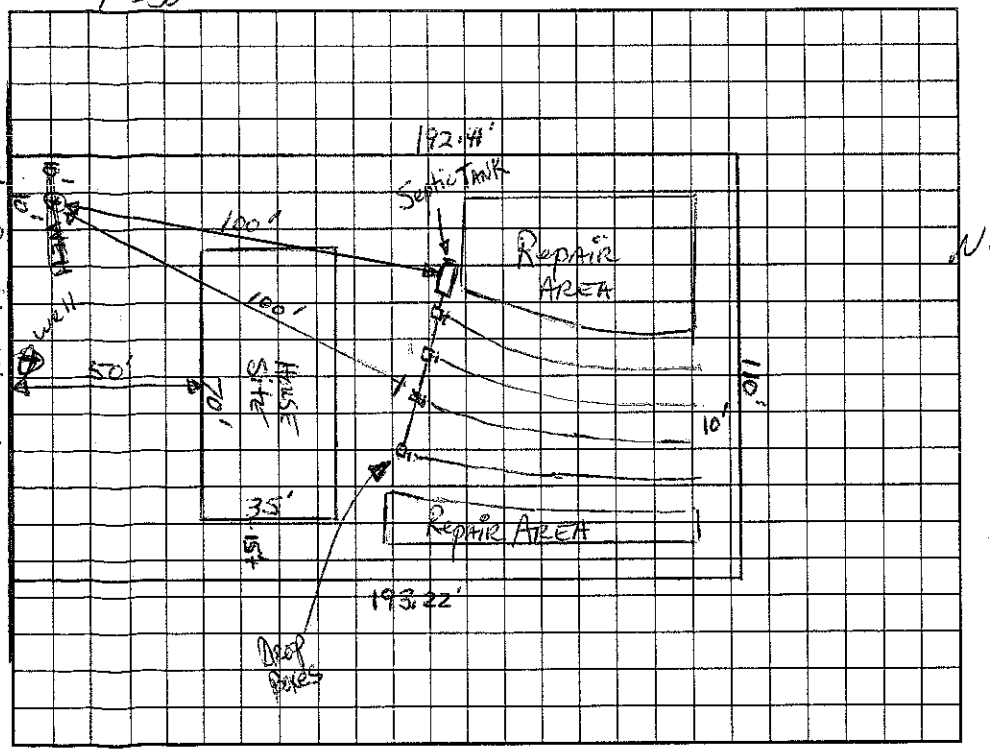

AS BUILT SKETCH

Change in Well Location

Installed in 5 Lines @ 60'

New Well is Located 100' from all Septic Systems

Well not installed at time of inspection

Permit can be suspended or revoked if any false information is supplied toward securing the permit/any unauthorized changes are made to the site/any unauthorized changes are made in the installation of the system. Improvement Permit with plat valid without expiration. Improvement Permit with site plan valid for sixty months. Authorization to Construct is valid for a period equal to that of Improvement Permit – not to exceed sixty months.

Signed: Steph M. Rogers date 10-20-00 Installed by: A-1 Backhoe

Improvement Permit by: RS date 10-19-00 Operation Permit by: RS date 3/15/02

Authorization to Construct by: Wesley Sparks RS. date 2/21/02 Existing System Inspection by: date

HEALTH DEPT. COPY: WHITE OWNER COPY (FINAL): YELLOW OWNER COPY (INITIAL): PINK