IREDELL COUNTY HEALTH DEPARTMENT

STATESVILLE 704-878-5305 50.00 Paid MOORESVILLE 704-664-5281

IMPROVEMENT PERMIT / AUTHORIZATION TO CONSTRUCT / OPERATION PERMIT / EXISTING SYSTEM INSPECTION

PERMIT# 090929 PIN# ~~4658 99 5249~~ 4668-01-1075 DATE 4/4/02

OWNER OR CONTRACTOR Schultte Homes PHONE: Business Home

ADDRESS Trantwon, NC 28166

LOCATION 115N TR Shinnville Rd TL Carolina Wren Corner lot on (L)

SUBDIVISION Grace Meadows BLOCK / SECTION LOT 32 LOT AREA 20,431 FT² SITE CLASS PS DESIGN FLOW 360 L.T.A.R. 3

Septic Tank: 1000 Gallons; STB 1012 Date 10/9/01
Pump Tank: Gallons; PT Date
Pump Make: Model Serial No.
Nitrification Field: No Fields 1 Square Feet 630 Linear Feet 210
No Lines 3 Trench Width 3' Max Trench Bottom Depth 3'

[X] New System [ ] Repair System Type: I, II, (III) IV, V, VI
System Description: GRAVITY - PPBPS
Repair System Description: Pump - PPBPS
Maintenance Agreement Required: [ ] Yes [X] No
~~Gravel Depth~~ SAND

[X] House/Mod. Home No. Bedrooms 3
[ ] Mobile Home No. Bathrooms 2
[ ] Business No. Employees
[ ] Other
[ ] Slab [X] Crawl Space [ ] Basement w/plumbing [ ] Basement wo/plumbing


Water Supply: [X] Individual [ ] Public [ ] Community

Comments/Conditions:

Comments/Conditions:

(1" = 50')

INITIAL SITE SKETCH

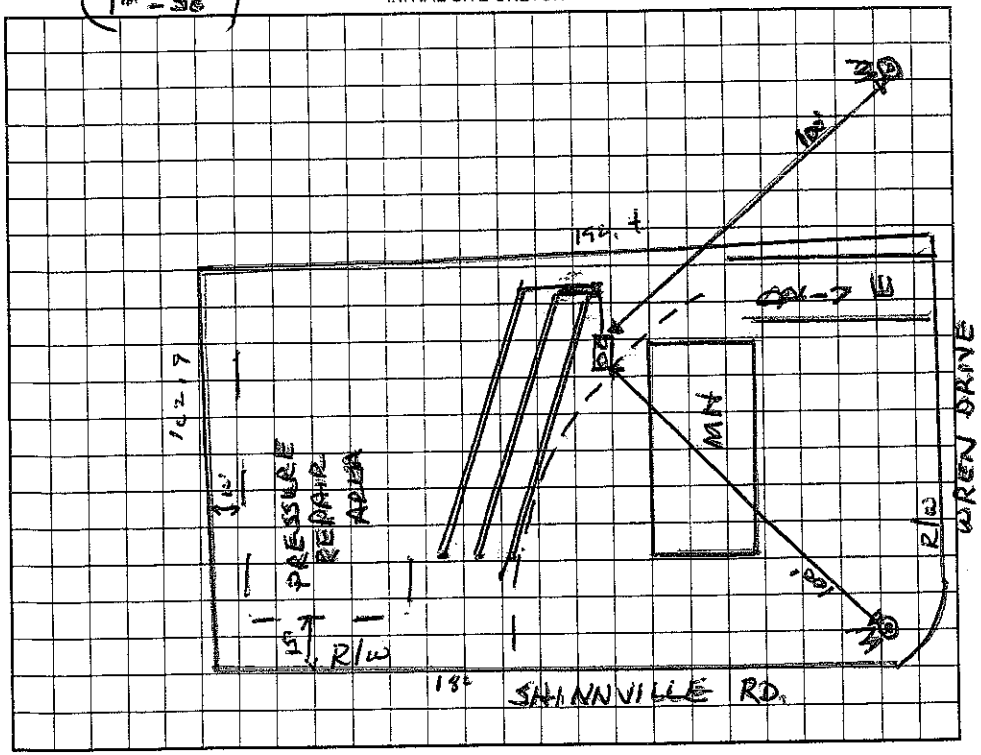

AS BUILT SKETCH

Permit can be suspended or revoked if any false information is supplied toward securing the permit/any unauthorized changes are made to the site/any unauthorized changes are made in the installation of the system. Improvement Permit with plat valid without expiration. Improvement Permit with site plan valid for sixty months. Authorization to Construct is valid for a period equal to that of Improvement Permit – not to exceed sixty months.

Signed: Dennis Ballew date 4-8-02

Improvement Permit by: date

Authorization to Construct by: date

Installed by: A-1 Backhoe

Operation Permit by: Wesley Sparks R.S. date 3/25/02

Existing System Inspection by: date

HEALTH DEPT. COPY: WHITE OWNER COPY (FINAL): YELLOW OWNER COPY (INITIAL): PINK