IREDELL COUNTY HEALTH DEPARTMENT

STATESVILLE 704-878-5305 MOORESVILLE 704-664-5281

IMPROVEMENT PERMIT / AUTHORIZATION TO CONSTRUCT / OPERATION PERMIT / EXISTING SYSTEM INSPECTION

Paid 1250.00 10-27

PERMIT# 090846 PIN# 4658995249 (pt) 4668-09-1398 DATE Dec. 17, 00

OWNER OR CONTRACTOR Mid Carolina Dev. // Donald R. Shreve PHONE: Business 634-0173 Home

ADDRESS PO Box 1580 Cornelius NC 28031

LOCATION 115-21 N TR Shinnville Rd. TL Carolina Wren on Right

SUBDIVISION Grace Meadows BLOCK / SECTION LOT 2 LOT AREA .55Ac SITE CLASS. RS DESIGN FLOW 360gpd L.T.A.R. .03

Septic Tank: 1000 Gallons; STB 825 Date 9/8/02
Pump Tank: 1000 Gallons; PT 502 Date 5/2/02
Pump Make: Zoeller Model N98 Serial No.
Nitrification Field: No Fields 1 Square Feet 900 Linear Feet 300
No Lines 3 Trench Width 36" Max Trench Bottom Depth 36" Gravel Depth N/A

☑ New System ☐ Repair System Type: I. II. III IV. V. VI
System Description: PM Innovative -25% Red.
Repair System Description: LP Panel Block
Maintenance Agreement Required: ☐ Yes ☑ No initially

☐ House/Mod. Home No. Bedrooms 3
☑ Mobile Home DW No. Bathrooms 2
☐ Business No. Employees
☐ Other
☐ Slab ☑ Crawl Space ☐ Basement w/plumbing ☐ Basement wo/plumbing


Water Supply: ☑ Individual ☐ Public ☐ Community

Comments:/Conditions: Install well & Septic System Exactly Where Shown. Maintain 100' minimum well & Septic System Separation OK to move home site towards left property line in order to leave space for garage on right side of home. Also OK to move home back 5' NKH

Comments:/Conditions:

1"=50'

INITIAL SITE SKETCH

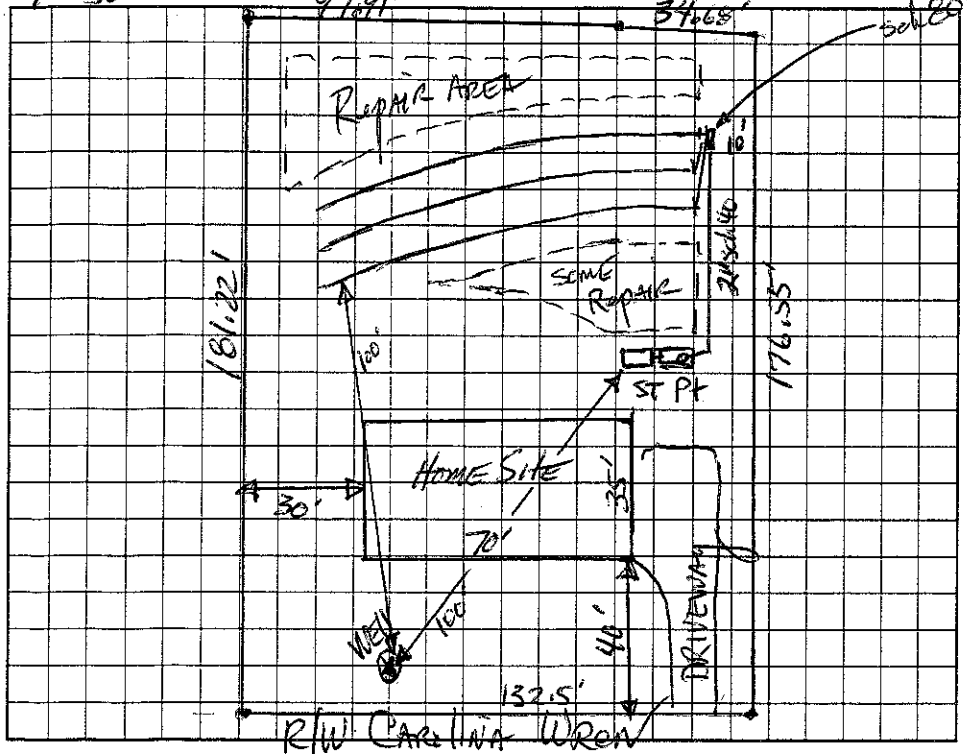

AS BUILT SKETCH

Ez Flow Installed

Permit can be suspended or revoked if any false information is supplied toward securing the permit/any unauthorized changes are made to the site/any unauthorized changes are made in the installation of the system. Improvement Permit with plat valid without expiration. Improvement Permit with site plan valid for sixty months. Authorization to Construct is valid for a period equal to that of Improvement Permit – not to exceed sixty months.

Signed: Steve B. date 12-15-00 Installed by: Bobis Backhoe

Improvement Permit by: date 12-12-00 Operation Permit by RS date 3/25/03

Authorization to Construct by: date 9-9-02 Existing System Inspection by: date

HEALTH DEPT. COPY: WHITE OWNER COPY (FINAL): YELLOW OWNER COPY (INITIAL): PINK