IREDELL COUNTY HEALTH DEPARTMENT

STATESVILLE 704-878-5305 125.00 Paid 1/30 MOORESVILLE 704-664-5281

IMPROVEMENT PERMIT / AUTHORIZATION TO CONSTRUCT / OPERATION PERMIT / EXISTING SYSTEM INSPECTION

PERMIT# 088999 PIN# ~~4660003656 PT~~ 4668-09-6465 DATE 10/29/01

OWNER OR CONTRACTOR KFS INVESTMENTS / Lyle E. Calkins PHONE: Business 664-3671 Home

ADDRESS 149 YACHT COVE LN MOORESVILLE 28115

LOCATION 1.5 N- IR SHENNVILLE RD - TL BROOKGLEN - 2nd ON LT

SUBDIVISION BROOKGLEN BLOCK / SECTION 2 LOT 28 LOT AREA .654C SITE CLASS. PS DESIGN FLOW 360GPD L.T.A.R. .36PD/M2

Septic Tank: 1000 Gallons; STB 312 Date 10/14/02
Pump Tank: Gallons; PT Date
Pump Make: Model Serial No.
Nitrification Field: No Fields 1 Square Feet 900 Linear Feet 300
No Lines 4@75' Trench Width 36" Max Trench Bottom Depth 36" Gravel Depth N/A

☑ New System ☐ Repair System Type: I, II, III, IV, V, VI
System Description: GRAVITY 25% REDUCTION
Repair System Description: SAME
Maintenance Agreement Required: ☐ Yes ☑ No


☑ House/Mod. Home No. Bedrooms 3
☐ Mobile Home No. Bathrooms 3
☐ Business No. Employees
☐ Other
☐ Slab ☑ Crawl Space ☐ Basement w/plumbing ☐ Basement wo/plumbing

Water Supply: ☑ Individual ☐ Public ☐ Community

Comments:/Conditions:

Comments:/Conditions:

INITIAL SITE SKETCH 1"=50'

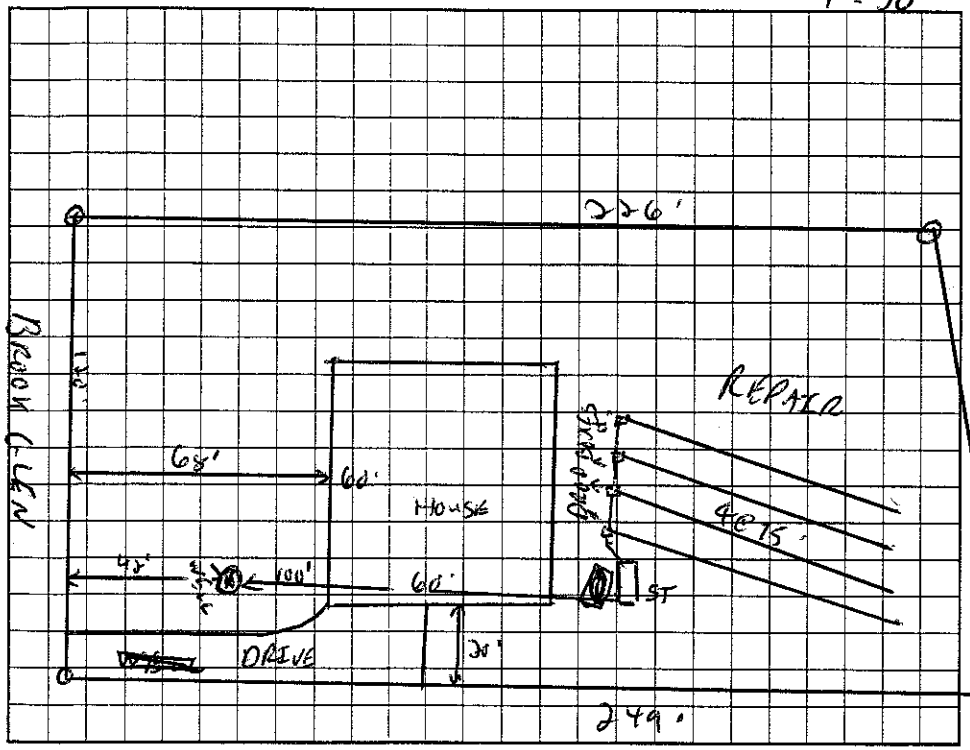

AS BUILT SKETCH

E-Z FLOW Installed
AS Drawn
D-Box

Permit can be suspended or revoked if any false information is supplied toward securing the permit/any unauthorized changes are made to the site/any unauthorized changes are made in the installation of the system. Improvement Permit with plat valid without expiration. Improvement Permit with site plan valid for sixty months. Authorization to Construct is valid for a period equal to that of Improvement Permit – not to exceed sixty months.

Signed: date 10/30/01 Installed by: Christen Bowy

Improvement Permit by: C. Lyerly RS date 10/29/01 Operation Permit by: G. Mabry RS date 1/9/03

Authorization to Construct by: G. Mabry RS date 10/18/02 Existing System Inspection by: date

HEALTH DEPT. COPY: WHITE OWNER COPY (FINAL): YELLOW OWNER COPY (INITIAL): PINK