IREDELL COUNTY HEALTH DEPARTMENT

STATESVILLE 704-878-5305 MOORESVILLE 704-664-5281

IMPROVEMENT PERMIT / AUTHORIZATION TO CONSTRUCT / OPERATION PERMIT / EXISTING SYSTEM INSPECTION

400 Inpatient

PERMIT# 39154 PIN# 4669003656 PT 4668-09-8853 DATE 4/30/01

OWNER OR CONTRACTOR KFS INVESTMENTS PHONE: Business 664-3671 Home

ADDRESS 149 YACHT COVE LN

LOCATION 115 N- TL SHINNVILLE - TL BROOKGLEN - ON RT

SUBDIVISION BROOK GLEN BLOCK / SECTION 1 LOT 8 LOT AREA .54AC SITE CLASS. PS DESIGN FLOW 360 GPD L.T.A.R. .30 GPD/FT

PAID CSH

Septic Tank: 1000 Gallons; STB 1012 Date 6-17-01
Pump Tank: ____ Gallons; PT ____ Date ____
Pump Make: ____ Model ____ Serial No. ____
Nitrification Field: No Fields 1 Square Feet 900 Linear Feet 300
No Lines 4@75' Trench Width 36" Max Trench Bottom Depth 36" Gravel Depth N/A

☑ New System ☐ Repair System Type: I, II, III, IV, V, VI
System Description: GRAVITY 25% REDUCTION
Repair System Description: GRAV/PUMP SAME
Maintenance Agreement Required: ☐ Yes ☑ No


☑ House/Mod. Home No. Bedrooms 3
☐ Mobile Home No. Bathrooms 2
☐ Business No. Employees ____
☐ Other ____
☐ Slab ☑ Crawl Space ☐ Basement w/plumbing ☐ Basement wo/plumbing

Water Supply: ☑ Individual ☐ Public ☐ Community

Comments:/Conditions:

Comments:/Conditions: Poly lok fitter installed

INITIAL SITE SKETCH 1" = 50'

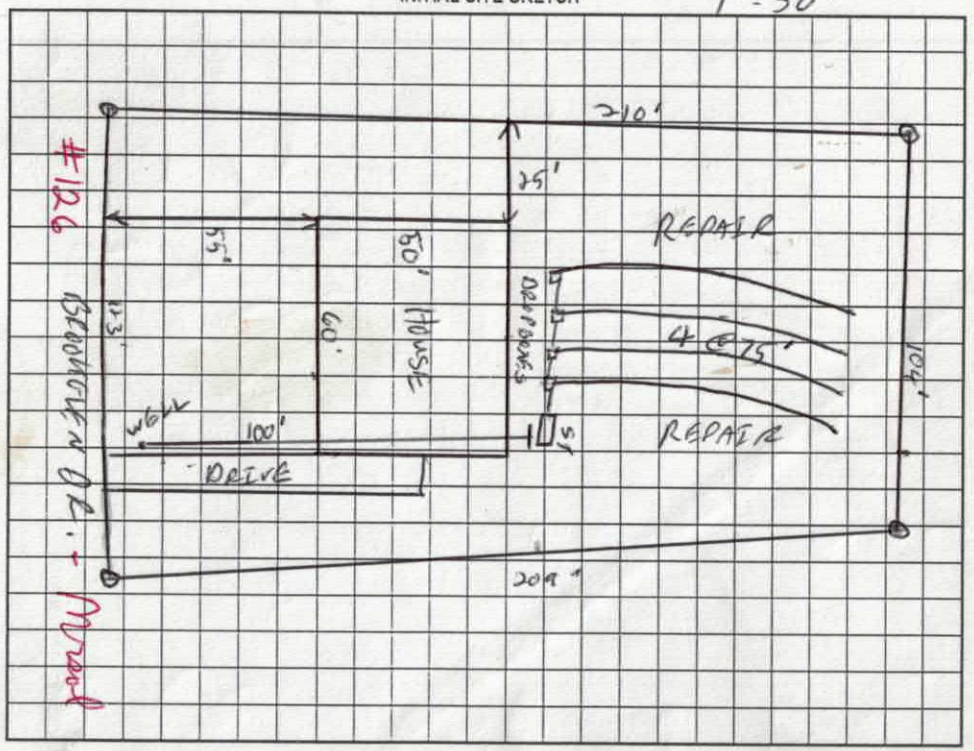

AS BUILT SKETCH

Installed "Plastic Chamber" Drainlines

Permit can be suspended or revoked if any false information is supplied toward securing the permit/any unauthorized changes are made to the site/any unauthorized changes are made in the installation of the system. Improvement Permit with plat valid without expiration. Improvement Permit with site plan valid for sixty months. Authorization to Construct is valid for a period equal to that of Improvement Permit – not to exceed sixty months.

Signed: ____ date 6.11.01

Improvement Permit by: C. Fox RS date 1/30/01

Authorization to Construct by: C. Fox RS date 5/7/01

Installed by: Tommy Fox

Operation Permit by: Mina H. Dotson RS date 9/18/2001

Existing System Inspection by: ____ date ____

HEALTH DEPT. COPY: WHITE OWNER COPY (FINAL): YELLOW OWNER COPY (INITIAL): PINK